

# LUCAS

## CONSTRUCTION NOTES (CITY OF BALLARAT)

## SITE MANAGEMENT

1. Prior to commencement of works on site, the contractor must ensure that all matters relating to the Occupational Health and Safety Act 2004, including all relevant regulations, have been addressed. In particular, the required notifications must be conveyed to the Victorian Workcover Authority - Health & Safety division with respect to trenching operations. Details of the contractors occupational health & safety procedures must be lodged with the Superintendent prior to commencement of works.
2. All native trees and shrubs to be retained unless road construction necessitates their removal or removal is directed by the engineer. A town planning permit is required for the removal of native trees and/or vegetation. The removal or retention of any existing trees must be in accordance with the approved landscape plan, or else approval will be required from the City of Ballarat landscape approvals officer.
3. Existing dams or watercourses to be excavated to a firm base and backfilled as specified. Consulting engineer to be notified when the dam or watercourses are excavated to a firm base. No filling is to be placed prior to dams being inspected and levels taken. Backfilling is to be carried out to the satisfaction of the Superintendent and Council Works Supervisor.
4. Prior to commencement of works, the contractor must submit a Construction Management Plan (CMP) to the Superintendent for approval. The contractor must comply with the recommendations of the Environment Protection Authority publication No.275 "Construction techniques for sediment pollution control". Appropriate siltation control is to be maintained throughout the construction and maintenance period of the works.

## GENERAL

5. All levels are in metres to Australian Height datum and taken from Level Plan by Beveridge Williams & Co. Pty Ltd.
6. All works to be carried out in accordance with AS2124-1992 General Conditions of Contract, City of Ballarat and Infrastructure Design Manual (IDM) current specification and standard drawings and to the satisfaction of the Superintendent and City of Ballarat works supervisor. The contractor shall ensure that they are conversant with all current revisions, amendments and updates that have been made that have been made to these standards.
7. The Superintendent, Council and all service authorities should be notified by the contractor, in writing, seven days prior to commencement of the works.
8. All existing services shall be confirmed to have been located prior to commencement of works. Where services have not been previously proven or located the Contractor shall make allowance or be satisfied that construction in accordance with the design can be achieved.
9. Where works are in the vicinity of existing services these services are to be located and the various authorities notified prior to the commencement of works.
10. The contractor shall erect and maintain all shoring, planking and strutting, dewatering devices, barricades, signs, lights, etc., necessary to keep works in a safe and stable condition and for the protection of the public.
11. Before commencement of works on trenches in excess of 1.5m deep, the civil contractors construction supervisor must give notice in writing of such proposals to Worksafe Victoria in accordance with Part 5.1, Division 4 of the Occupational Health & Safety regulations (2007) and undertake safety precautions in trenching operations in accordance with Workcover's Code of Practice (1988).
12. Lots to be graded (1 in 200 min slope) & left clean to the satisfaction of the engineer. Finished levels to be compatible with lots adjoining this stage.
13. On completion the contractor is responsible for the removal of all rubbish and spoil from site. No surplus trees, vegetation or other material is to be burnt on site.
14. Reserves to be free draining and to be left in a condition satisfactory to the Superintendent and City of Ballarat works supervisor.
15. All TBM's and control points are to be maintained and protected at all times during construction. Should any marks be disturbed, the contractor will immediately notify the consultant to arrange re-instatement at the contractors expense.

## EARTHWORKS

16. All areas shown on the drawings to be cut or filled are to be stripped of topsoil (unless filling is less than 200mm) and all topsoil must be stockpiled on site.
17. Upon completion of the bulk earthworks topsoil is to be spread to a depth of 100mm over the nominated area and graded to finished levels shown on the drawings with a minimum slope of 1 in 200.
18. Batters to be 1 in 5 for fill and 1 in 5 for cut unless noted otherwise.
19. All native strips and batters shall be covered with 75mm min. depth topsoil and seeded with an approved seed.
20. Filling in all properties and road reserves is to be carried out using approved clay fill. Top soil and all vegetable matter to be stripped from site prior to filling. All filling to be carried out in 150mm layers. For lot fill and general fill compact to 95% of max dry density For road subgrade (to depth of 0.3m) compact to 98% of max dry density.
21. Importing Fill: All imported fill must be tested by a NATA approved laboratory to ensure it is suitable for use on site, and any contaminants are within accepted levels. Under No circumstances should fill material enter or leave the site without the permission of the Superintendent or prior to it being appropriately tested.
22. All fill material shall be clean, uniform and free of organic material and meet requirements of AS 3798-2007 "Guidelines on Earthworks for Commercial and Residential Developments".
23. Fill material should be placed in layers of uniform thickness, deposited systematically across the fill area. The contractor must excavate or "box" into the existing surface at the edge of fill to provide a suitable junction with the existing surface and to avoid feathered edges.
24. Prior to disposal of excess spoil the truck route and disposal location is to be approved by the Superintendent prior to commencing to dispose of spoil.
25. All vehicles transporting fill material to and from the site must have appropriate measures in place to ensure that material does not get onto roads and into stormwater systems and natural waterways.
26. Cut batters behind vehicular accesses must not exceed maximum grade of 1 in 8.
27. Before any loose layer of fill is compacted, the material and its moisture condition should be as uniform as is practicable throughout its depth.
28. If there is a delay in the placement of subsequent fill layers, previously accepted layers should conform with the specification before further fill is placed. If these layers have wetted up or dried out, they may inhibit compaction or cause heaving of subsequent layers. In these instances, drying or wetting of the fill by the contractor will be required to achieve optimum compaction.

29. All lots are to be brought to a finished surface level and top soiled to ensure that front boundaries are a minimum of 125mm above the top of kerb.
30. The maximum particle size of any rocks or other lumps within the fill layer, after compaction, should not exceed 100mm or two-thirds of the compacted layer thickness.
31. Fill is to be tested in increments of depth not greater than 500mm.
32. Fill batter faces are to be overfilled and cut back; the trimmed and compacted face should have a roughened surface to reduce runoff.
33. The surface of all fill layers must be shaped to provide drainage and to prevent ponding.
34. All fill to be compacted to that shown or 95% standard density or better. Moisture content must be in the range of -10% to +5% optimum.
35. Where fill placement is less than 200mm stripping of topsoil may be deleted.
36. Filling to be completed prior to sewer and drainage construction, unless approved by the Superintendent and relevant Authority.

## ROADWORKS

37. 100mm dia. agricultural pipe drains (Refer BCC SD-D2-1) to be placed behind kerb and channel or as directed by Superintendent and at minimum grade of 1 in 250.
38. The water conduit offset from the lot boundary is given on the water reticulation plan. The contractor must construct conduits to accord with the given offset and ensure that the concreter marks the kerb and footpath exactly above the conduit.
39. All footpaths and shared pedestrian/bicycle paths are to be 125mm thick concrete as per IDM Standard Drawings SD205, 210, 215, 220 and 225.
40. Telecommunication contractor to be notified seven (7) days prior to concrete works being placed.
41. Electrical distribution pits within footpaths are to be a minimum of 300mm from the edge of the path. Concrete is to be placed around distribution pits to a minimum depth of 200mm.
42. All street signs to be constructed and erected to current City of Ballarat standards including logo. Sign to be placed in 3000 hole 500mm deep 15MPa concrete to 100mm below FSL of nature strip.
43. Traffic control signs, markings & delineators to be installed in accordance with AS1742.2. All line marking is to be long life road marking, with longitudinal lines in thermoplastic and transverse markings in cold applied.
44. Kerb transition to take place in the minor street over a 1.0m length from either the tangent point or TP pit.
45. Existing road works to be reconstructed as required to provide, without discontinuity, a connection in accordance with design levels and grades.
46. Tactile ground surface indicators (TGSIs) are to be installed at all pram crossings and pedestrian cross points in accordance with AS1428.4 : 2002 and BCC Standard Drawings SD-C4.

## PAVEMENT

47. Pavement shall be constructed in accordance with construction plans, IDM and City of Ballarat Specifications and Standard Drawings.
48. Modification of the pavement requires approval by the City of Ballarat and Superintendent.
49. Prior to the commencement of the works, the contractor shall provide to Superintendent and Council the following information:-
  - a. Source of quarry material.
  - b. Optimum Moisture Content and Maximum Modified Dry Density of the F.C.R to be used (from NATA approved laboratory)
  - c. If the source of the quarry material is changed during the course of the works, new test results shall be provided.
50. Subgrade, sub base and base compaction densities shall be in accordance with that shown in Table 1 and Clause 304.07 of Vicroads Standard Specification for Roadworks and Bridgeworks.
51. Compaction testing must be undertaken by NATA approved laboratory.
52. Compaction testing and proof rolling shall be undertaken on same day.
53. Superintendent and Council must be given minimum 24 hours notice of proof roll.
54. All pavement areas shall be proof rolled in the presence of Superintendent and Council Inspection Engineer, at the expense of contractor and in accordance with AS 3798 and Clause 173 and 204.12 of Vicroads Standard Specification for Roadworks and Bridgeworks.
55. If more than 20 percent of pavement area fails proof roll then total area must be reworked.
56. The next layer of pavement shall not be placed until previous layer has been approved. Following approval the contractor shall ensure that the next layer is placed within a reasonable period of time. If this is not possible it is the contractors responsibility to protect the pavement already approved. Failure to do so shall render contractor responsible for any pavement damage and rectification.
57. All geotechnical and compaction results are to be submitted to Superintendent and Council.

## DRAINAGE

58. Drainage and pits to be set out from offsets shown rather than from centreline pipe chainages.
59. Stormwater pits shall be reinforced concrete and constructed in accordance with IDM and City of Ballarat Specifications and Standard Drawings. Minimum drop through pit shall be 20mm unless shown otherwise. For specific details refer Pit Schedule and IDM Standard Drawings SD 400 to SD 495. Minimum Concrete Strength  $f_{ck}$  25MPa at 28 Days.
60. Precast pits are permitted where manufacturer can demonstrate compliance with requirements of IDM and City of Ballarat Specifications and Standard Drawings.
61. Pit Covers and surrounds in trafficable areas shall be Class D Gatic or similar, other areas shall be Class B precast reinforced concrete unless otherwise shown.
62. All pipes under pavement to be RCP(RRJ) Class 3. All 150mm diameter pipes to be UPVC SN4. Pipes other than under pavement or trafficable area may be approved ribbed stormwater pipe such as Blackmax or Stormpro®. Where ribbed stormwater pipe is used embedment shall be to manufacturers specification.
63. Pipe trenches beneath the road pavement and footpath to be backfilled with 20mm Class 3 F.C.R. at All other locations backfill with an approved material to a minimum 300mm above top of pipe. Backfill material shall be in maximum 150mm

layers and in accordance with BCC Standard Drawing SD-D8-1.

64. Pipe trenches behind kerb and in easements or nature strips to be backfilled with Red Dredge or other approved material in 150mm layers to 300mm above top of pipe and in accordance with BCC Standard Drawing SD-D8-1.
65. Easement Property Inlets at rear of property shall be 100mm PVC SN4 constructed in accordance with BCC Standard Drawing SD-D9 located 1.0m. from the low corner of the lot unless otherwise shown.
66. House Drain Property Inlets at front of property shall be 100mm PVC SN4 constructed in accordance with BCC Standard Drawing SD-D9 and located 1.0m from the low corner of the lot unless otherwise shown. Lots denoted H shall be connected to kerb. Lots denoted PI shall be connected to pipe to pit.
67. Property Inlets for allotments shall be at a sufficient depth to control drainage at minimum of 1 in 200 fall from all points within the building area.
68. All proposed drainage stubs to be blanked off at end of pipe with timber planks to the satisfaction of the Superintendent and Council supervising engineer.
69. All drainage backfill under pavement shall be tested and results provided to the Superintendent.


## SERVICES

70. All service trenches under footpath, vehicular crossings and kerb & channel shall be backfilled with 20mm Class 3 crushed rock. All service conduit trenches under road pavement shall be excavated with compacted crushed rock.
71. Gas and water conduits and mains must be laid in trenches excavated and backfilled by the contractor. Conduits are to be 50mm diameter Class 12 PVC service conduits laid at a minimum depth of 600mm below finished surface level. Contractor shall supply all sand embedment. The contractor shall give the gas contractor 7 days notice prior to commencing work.
72. Telecommunications conduits and cable ducts must be laid in trenches excavated and backfilled by the contractor. Conduits are to be type and size as shown on approved telecommunications plans and laid at a minimum depth of 600mm below finished surface level. Contractor shall supply all sand embedment. The contractor shall give the Telecommunications contractor 7 days notice prior to commencing work.
73. Electrical conduits and cables must be laid in trenches excavated and backfilled by an VEDN approved contractor. Conduits are to be type and size as shown on approved electrical plans and laid at a minimum depth of 600mm below finished surface level. Contractor shall supply all sand embedment. The contractor shall give the Electrical contractor 7 days notice prior to commencing work.
74. All conduit ends immediately upon placement of the conduit must be plugged.
75. Conduits under footpaths to be 450mm deep extending a minimum of 250mm either side of the path. The footpath above the conduits is to be marked with two contraction joints over the conduits 400mm apart.
76. The reinstatement and compaction of public authority service trenches shall be the contractor's responsibility.
77. The contractor must note the existence of telecom, gas, power, water and any other services in the area prior to tendering. Any disturbance to existing services, footpaths etc. shall be rectified at the contractor's expense to the satisfaction of the superintendent and relevant service authority as appropriate.

### ATTENTION TO CONTRACTOR

In accordance with Clause 15 of AS2124 Australian Standard Conditions of Contract, the contractor must ensure the safety of the contractor's employees and all other people who are on or adjacent to the site. The contractor must comply with the Victorian Occupational Health and Safety Act

78. The contractor must ensure that all people employed on the site wear approved safety apparel. This includes safety helmets, vests, safety boots, eye & ear protection, where appropriate.
79. The contractor shall reinstate any affected footpath, vehicle crossing and nature strip to the satisfaction of the City of Ballarat
80. Beveridge Williams & Co Pty Ltd is responsible for design of the works. Any proposed alterations to the design shall be directed to the consultant for approval prior to making any alterations to the design.
81. The contractor is directly responsible for the setout. Should actual site conditions conflict in any way with that documented, the contractor must contact the office of Beveridge Williams & Co. Pty. Ltd. for clarification before proceeding.

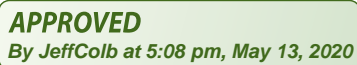

AS CONSTRUCTED  
PLANS



Beveridge Williams

96 Main Road  
Ballarat Vic 3350  
ph: 03 5327 2000  
[www.beveridgewilliams.com.au](http://www.beveridgewilliams.com.au)

A detailed map of the Crowther Drive area. The map shows Crowther Drive running vertically, with Evans Way at the top and Lee Road at the bottom. To the right of Crowther Drive is Shortridge Drive, and to the left is Soderstrom Street. Further down, Quirk Road runs horizontally, with Kernick Street to its right. Brind Way runs diagonally from the bottom right towards the center. Cote Drive runs vertically at the bottom right. The map is divided into several stages: Stage G1 is located between Evans Way and Lee Road; Stage G2 is located between Lee Road and Quirk Road; Stage E1 is located between Quirk Road and Kernick Street; and Stage E2 is located between Kernick Street and the bottom of the map. A 'SITE OF WORKS' is indicated by an arrow pointing to a specific location on Crowther Drive, between Lee Road and Quirk Road.

# SITE PLAN

NOT TO SCALE

## DRAWING INDEX

DRAWING No.	TITLE
1800971-G3-001	COVER SHEET
1800971-G3-002	TYPICAL ROAD CROSS SECTIONS, PAVEMENT MAKEUP & GENERAL DETAILS
1800971-G3-010	LAYOUT PLAN (SHEET 1 OF 2)
1800971-G3-011	LAYOUT PLAN (SHEET 2 OF 2)
1800971-G3-012	FINISHED SURFACE & OVERLAND FLOW PLAN (SHEET 1 OF 2)
1800971-G3-013	FINISHED SURFACE & OVERLAND FLOW PLAN (SHEET 2 OF 2)
1800971-G3-100	CROWTHER DRIVE LONGITUDINAL SECTIONS (SHEET 1 OF 6)
1800971-G3-101	CROWTHER DRIVE LONGITUDINAL SECTIONS (SHEET 2 OF 6)
1800971-G3-102	LEE ROAD LONGITUDINAL SECTIONS (SHEET 3 OF 6)
1800971-G3-103	EVANS WAY LONGITUDINAL SECTIONS (SHEET 4 OF 6)
1800971-G3-104	QUIRK ROAD LONGITUDINAL SECTIONS (SHEET 5 OF 6)
1800971-G3-105	SODERSTROM STREET LONGITUDINAL SECTIONS (SHEET 6 OF 6)
1800971-G3-200	CROWTHER DRIVE CROSS SECTIONS (SHEET 1 OF 7)
1800971-G3-201	CROWTHER DRIVE CROSS SECTIONS (SHEET 2 OF 7)
1800971-G3-202	CROWTHER DRIVE CROSS SECTIONS (SHEET 3 OF 7)
1800971-G3-203	LEE ROAD CROSS SECTIONS (SHEET 4 OF 7)
1800971-G3-204	EVANS WAY CROSS SECTIONS (SHEET 5 OF 7)
1800971-G3-205	QUIRK ROAD CROSS SECTIONS (SHEET 6 OF 7)
1800971-G3-206	SODERSTROM STREET CROSS SECTIONS (SHEET 7 OF 7)
1800971-G3-300	INTERSECTION DETAILS (SHEET 1 OF 2)
1800971-G3-301	INTERSECTION DETAILS (SHEET 2 OF 2)
1800971-G3-350	SIGNAGE & LINE MARKING PLANS (SHEET 1 OF 2)
1800971-G3-351	SIGNAGE & LINE MARKING PLANS (SHEET 2 OF 2)
1800971-G3-400	DRAINAGE LONGITUDINAL SECTIONS (SHEET 1 OF 3)
1800971-G3-401	DRAINAGE LONGITUDINAL SECTIONS (SHEET 2 OF 3)
1800971-G3-402	DRAINAGE LONGITUDINAL SECTIONS & PIT SCHEDULE (SHEET 3 OF 3)

© COPYRIGHT All rights reserved  
Beveridge Williams & Co. Pty Ltd has granted a licence to the principle to use this document for its intended purpose.  
No unauthorised copying is permitted

© COPYRIGHT All rights reserved Beveridge Williams & Co. Pty Ltd has granted a licence to the principle to use this document for its intended purpose. No unauthorised copying is permitted																				
D	CAPPING LAYER DESCRIPTION CHANGE	24.10.19	TT	.JS																
B	INTEGRA REVIEW	03.10.19	JS	.JZ																
C	AMENDED DRAINAGE	28.08.19	TT	.JS																
A	AMENDED AS PER COUNCIL COMMENTS	08.07.19	JS	.JZ	F	AS CONSTRUCTED PLANS								13.05.20	TT	.JS				
P1	AMENDED AS PER INTEGRAL COMMENTS	29.05.19	JS	.JZ	E	SODEROTRDM PLACE TO SODER STROM STREET								06.02.20	TT	.JS				
REV	DESCRIPTION	DATE	DRN	APP.	REV	DESCRIPTION								DATE	DRN	APP.				

Designed Date	J.SPARK 29.01.19
Drawn	J.SPARK
Approved Date	J.ZAAL 29.01.19
PS Number	PS825912E

Project Details	LUCAS STAGE G3 CITY OF BALLARAT
Drawing Title	COVER SHEET


Sheet 01 of 26		
Scale		
NOT TO SCALE		
Project Ref	Stage No	Drawing No
1800971	G3	00



X:\18\1800971 Lucas\ Encl\Stage G3\Drawings\1800971-G3-001-COV.dwg





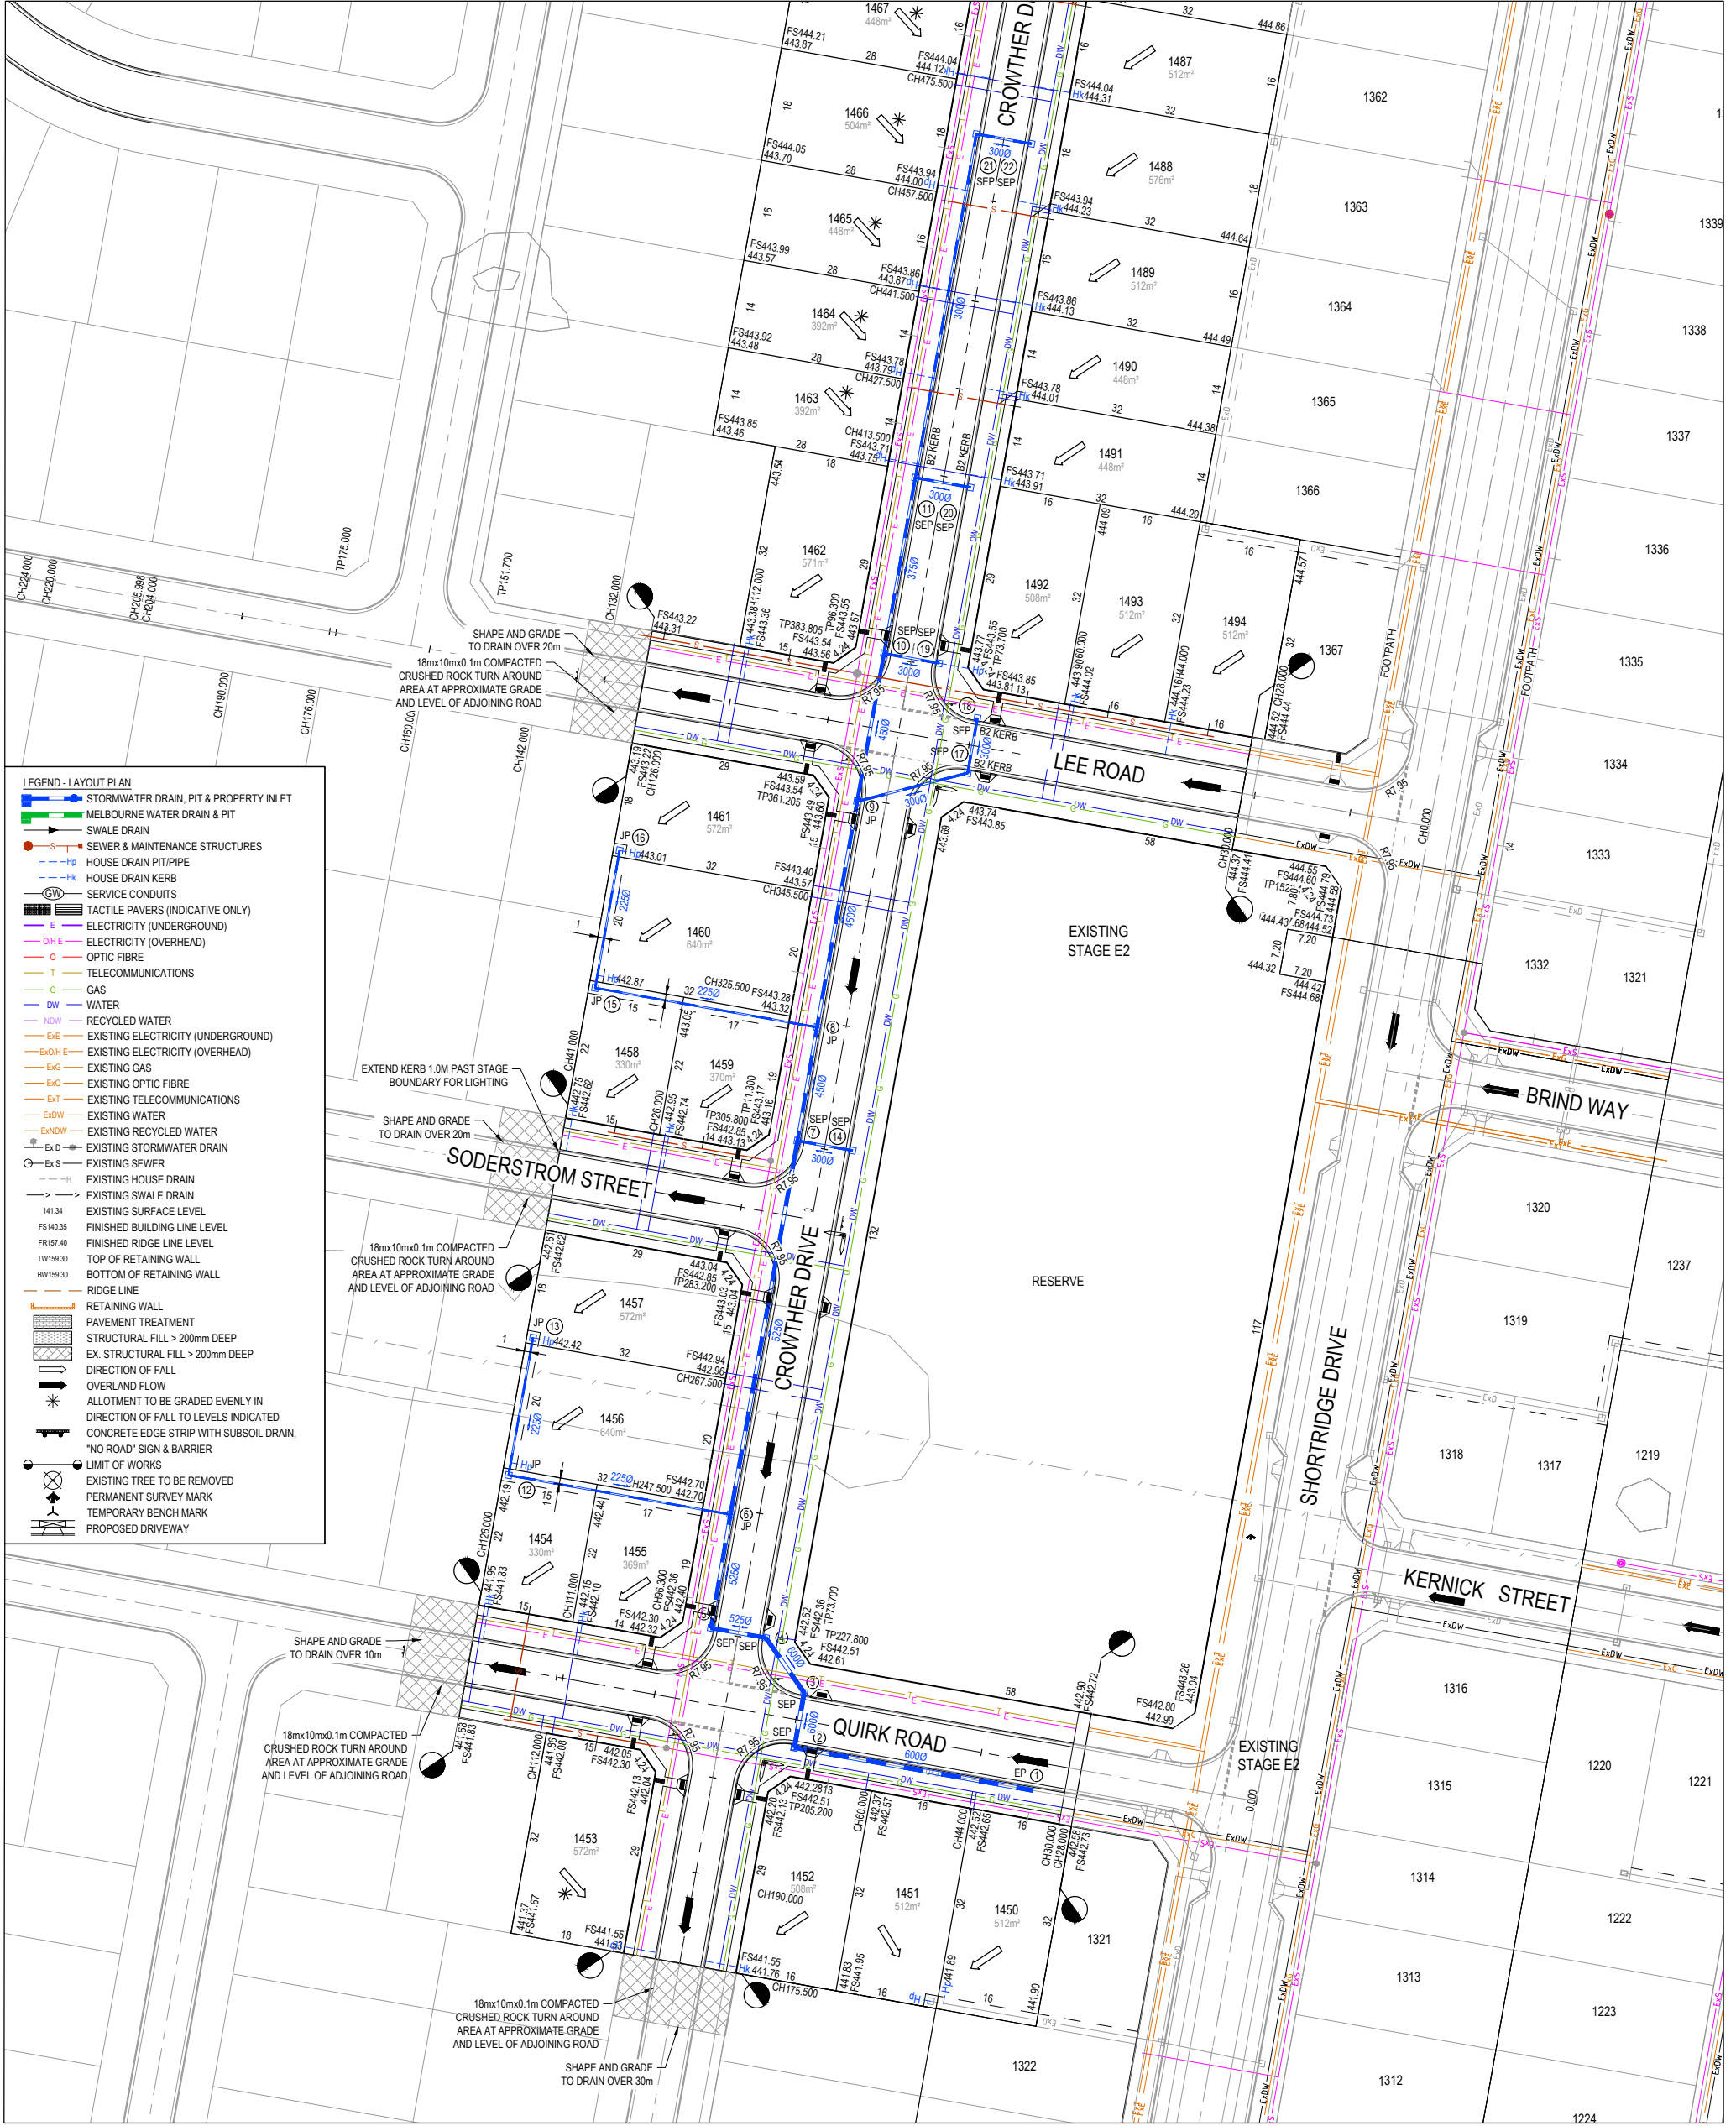

**LEGEND - LAYOUT PLAN**

- STORMWATER DRAIN, PIT & PROPERTY INLET
- MELBOURNE WATER DRAIN & PIT
- SWALE DRAIN
- SEWER & MAINTENANCE STRUCTURES
- HOUSE DRAIN PIT/PIPE
- HOUSE DRAIN KERB
- SERVICE CONDUITS
- TACTILE PAVERS (INDICATIVE ONLY)
- ELECTRICITY (UNDERGROUND)
- ELECTRICITY (OVERHEAD)
- OPTIC FIBRE
- TELECOMMUNICATIONS
- GAS
- WATER
- RECYCLED WATER
- EXISTING ELECTRICITY (UNDERGROUND)
- EXISTING ELECTRICITY (OVERHEAD)
- EXISTING GAS
- EXISTING OPTIC FIBRE
- EXISTING TELECOMMUNICATIONS
- EXISTING WATER
- EXISTING RECYCLED WATER
- EXISTING STORMWATER DRAIN
- EXISTING SEWER
- EXISTING HOUSE DRAIN
- EXISTING SWALE DRAIN
- EXISTING SURFACE LEVEL
- FINISHED BUILDING LINE LEVEL
- FINISHED RIDGE LINE LEVEL
- TOP OF RETAINING WALL
- BOTTOM OF RETAINING WALL
- RIDGE LINE
- RETAINING WALL
- PAVEMENT TREATMENT
- STRUCTURAL FILL > 200mm DEEP
- EX. STRUCTURAL FILL > 200mm DEEP
- DIRECTION OF FALL
- OVERLAND FLOW
- ALLOTMENT TO BE GRADED EVENLY IN DIRECTION OF FALL TO LEVELS INDICATED
- CONCRETE EDGE STRIP WITH SUBSOIL DRAIN, "NO ROAD" SIGN & BARRIER
- LIMIT OF WORKS
- EXISTING TREE TO BE REMOVED
- PERMANENT SURVEY MARK
- TEMPORARY BENCH MARK
- PROPOSED DRIVEWAY


ROAD NAME	SERVICES OFFSET SCHEDULE									
	GAS		WATER		ELECTRICITY		TELECOMMUNICATIONS		SEWER	
	SIDE	OFFSET (m)	SIDE	OFFSET (m)	SIDE	OFFSET (m)	SIDE	OFFSET (m)	SIDE	OFFSET
CROWTHER DRIVE	EAST	2.1	EAST	2.7	WEST	2.7	WEST	2.1	WEST	1.0
EVANS WAY	SOUTH	2.1	SOUTH	2.7	NORTH	2.7	NORTH	2.0	NORTH	1.0
LEE ROAD	SOUTH	2.1	SOUTH	2.7	NORTH	2.7	NORTH	2.1	SOUTH	1.0
SODERSTROM STREET	SOUTH	2.1	SOUTH	2.7	NORTH	2.7	NORTH	2.1	SOUTH	1.0
QUIRK WAY	SOUTH	2.1	SOUTH	2.7	NORTH	2.7	NORTH	2.1	SOUTH	1.0

**WARNING**  
**BWARE OF UNDERGROUND SERVICES**  
The locations of underground services are approximate only and their exact position should be proven on site.  
No guarantee is given that all existing services are shown.  
Locate all underground services before commencement of works  
**DIAL 1100 BEFORE YOU DIG**  
www.1100.com.au

**APPROVED**  
By Jeff Colb at 5:08 pm, May 13, 2020

**AS CONSTRUCTED PLANS**

REV	DESCRIPTION	DATE	DRN.	APP.
F	AS CONSTRUCTED PLANS	13.05.20	TT	JS
E	SODERSTROM PLACE TO SODERSTROM STREET	06.02.20	TT	JS
D	CAPPING LAYER DESCRIPTION CHANGE	24.10.19	TT	JS
C	INTEGRAL REVIEW	03.10.19	JS	JZ
B	AMENDED DRAINAGE	28.08.19	TT	JS

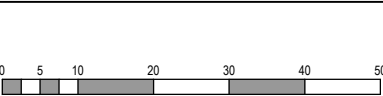

Designed  
Date  
J.SPARK  
29.01.19

Drawn  
J.SPARK

Approved  
Date  
J.ZAAL  
29.01.19

PS Number  
PS825912E

**BW** Beveridge Williams  
96 Main Road  
Ballarat Vic 3350  
ph: 03 5327 2000  
www.beveridgewilliams.com.au

Project Details  
LUCAS  
STAGE G3  
CITY OF BALLARAT

Drawing Title  
LAYOUT PLAN  
(SHEET 1 OF 2)

Sheet 03 of 26

Scale  
1:500 @ A1


Project Ref  
1800971

Stage No  
G3

Drawing No  
010

Rev  
F



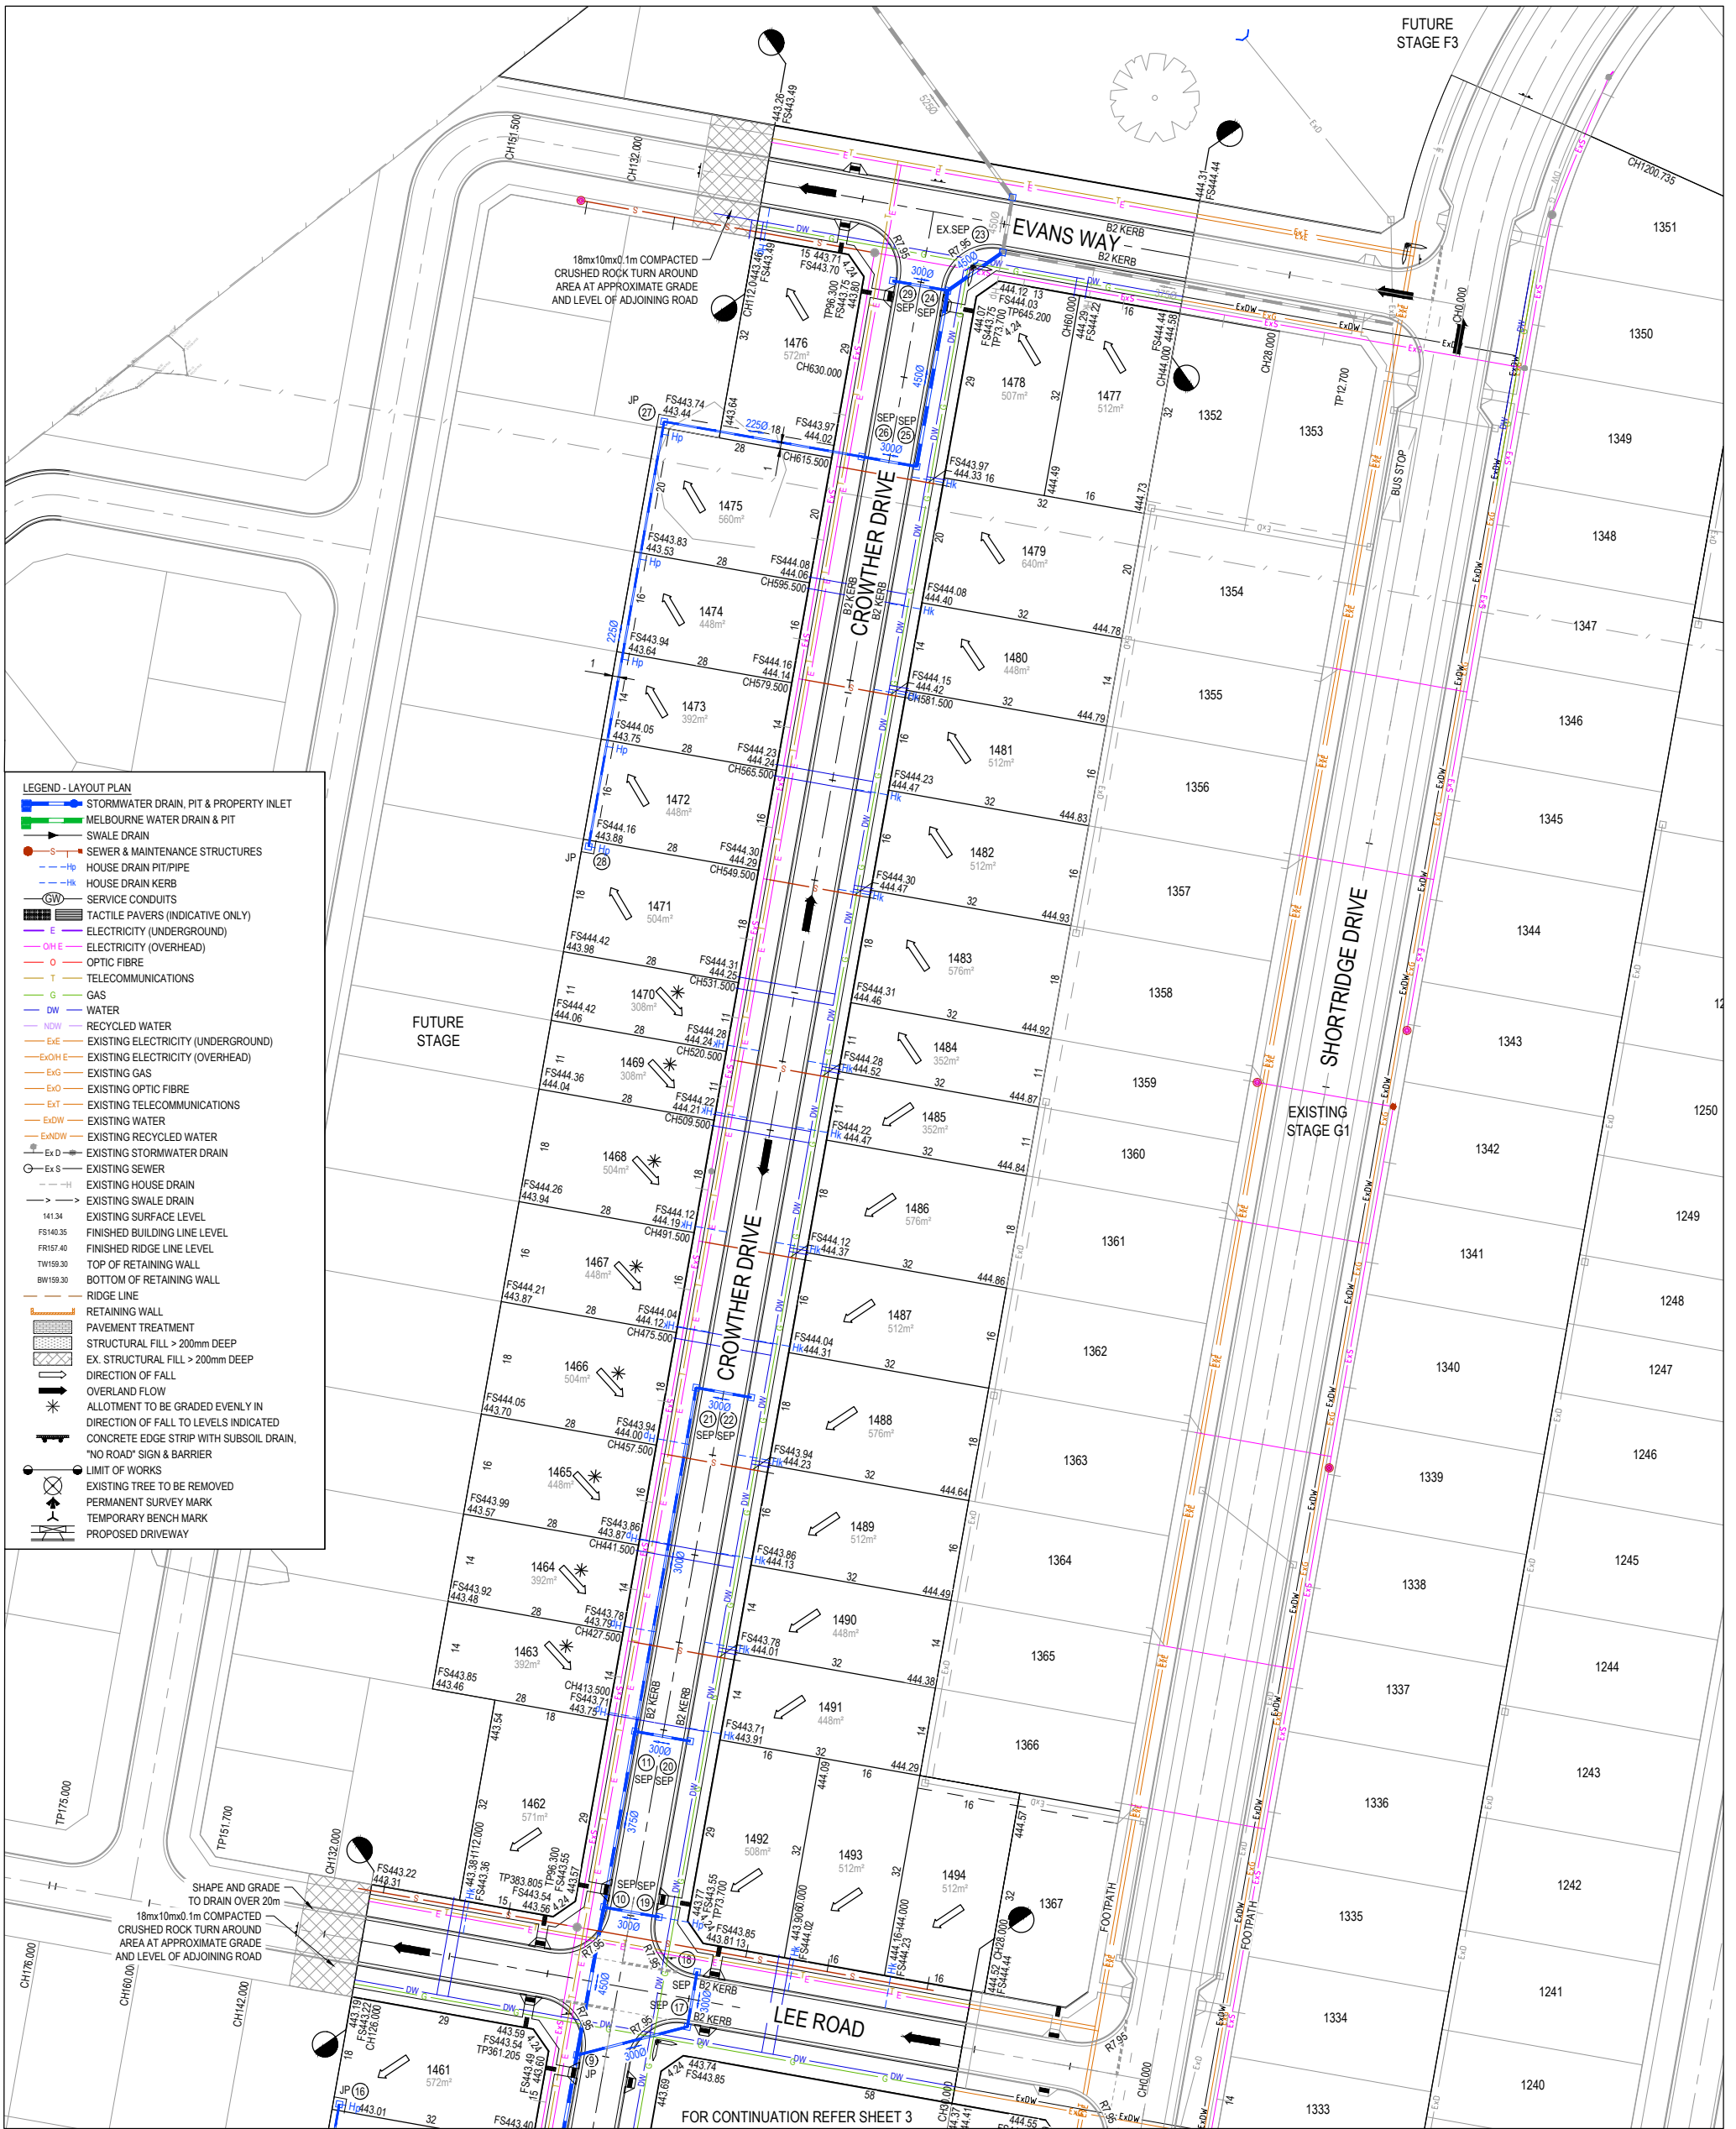


ROAD NAME	GAS		WATER		ELECTRICITY		TELECOMMUNICATIONS		SEWER	
	SIDE	OFFSET (m)	SIDE	OFFSET (m)	SIDE	OFFSET (m)	SIDE	OFFSET (m)	SIDE	OFFSET
CROWTHER DRIVE	EAST	2.1	EAST	2.7	WEST	2.7	WEST	2.1	WEST	1.0
EVANS WAY	SOUTH	2.1	SOUTH	2.7	NORTH	2.7	NORTH	2.0	NORTH	1.0
LEE ROAD	SOUTH	2.1	SOUTH	2.7	NORTH	2.7	NORTH	2.1	SOUTH	1.0
SODERSTROM STREET	SOUTH	2.1	SOUTH	2.7	NORTH	2.7	NORTH	2.1	SOUTH	1.0
QUIRK WAY	SOUTH	2.1	SOUTH	2.7	NORTH	2.7	NORTH	2.1	SOUTH	1.0

**WARNING**  
**BEWARE OF UNDERGROUND SERVICES**  
The locations of underground services are approximate only and their exact position should be proven on site.  
No guarantee is given that all existing services are shown.  
Locate all underground services before commencement of works  
**DIAL 1100 BEFORE YOU DIG**  
www.1100.com.au

**APPROVED**  
By Jeff Colb at 5:08 pm, May 13, 2020

**AS CONSTRUCTED  
PLANS**

© COPYRIGHT All rights reserved. Beveridge Williams & Co. Pty Ltd has granted a licence to the principle to use this document for its intended purpose. No unauthorised copying is permitted				
F	AS CONSTRUCTED PLANS	13.05.20	TT	JS
E	SODERSTROM PLACE TO SODERSTROM STREET	06.02.20	TT	JS
D	CAPPING LAYER DESCRIPTION CHANGE	24.10.19	TT	JS
C	INTEGRAL REVIEW	03.10.19	JS	JZ
B	AMENDED DRAINAGE	28.08.19	TT	JS
REV	DESCRIPTION	DATE	DRN.	APP.

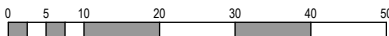

Designed  
Date  
J.SPARK  
29.01.19  
Drawn  
J.SPARK  
Approved  
Date  
J.ZAAL  
29.01.19  
PS Number  
PS825912E



**Beveridge Williams**  
96 Main Road  
Ballarat Vic 3350  
ph: 03 5327 2000  
www.beveridgewilliams.com.au

Project  
Details  
LUCAS  
STAGE G3  
CITY OF BALLARAT  
Drawing  
Title  
LAYOUT PLAN  
(SHEET 2 OF 2)


Sheet 04 of 26

Scale  
1:500 @ A1

Project Ref	Stage No	Drawing No	Rev
1800971	G3	011	F





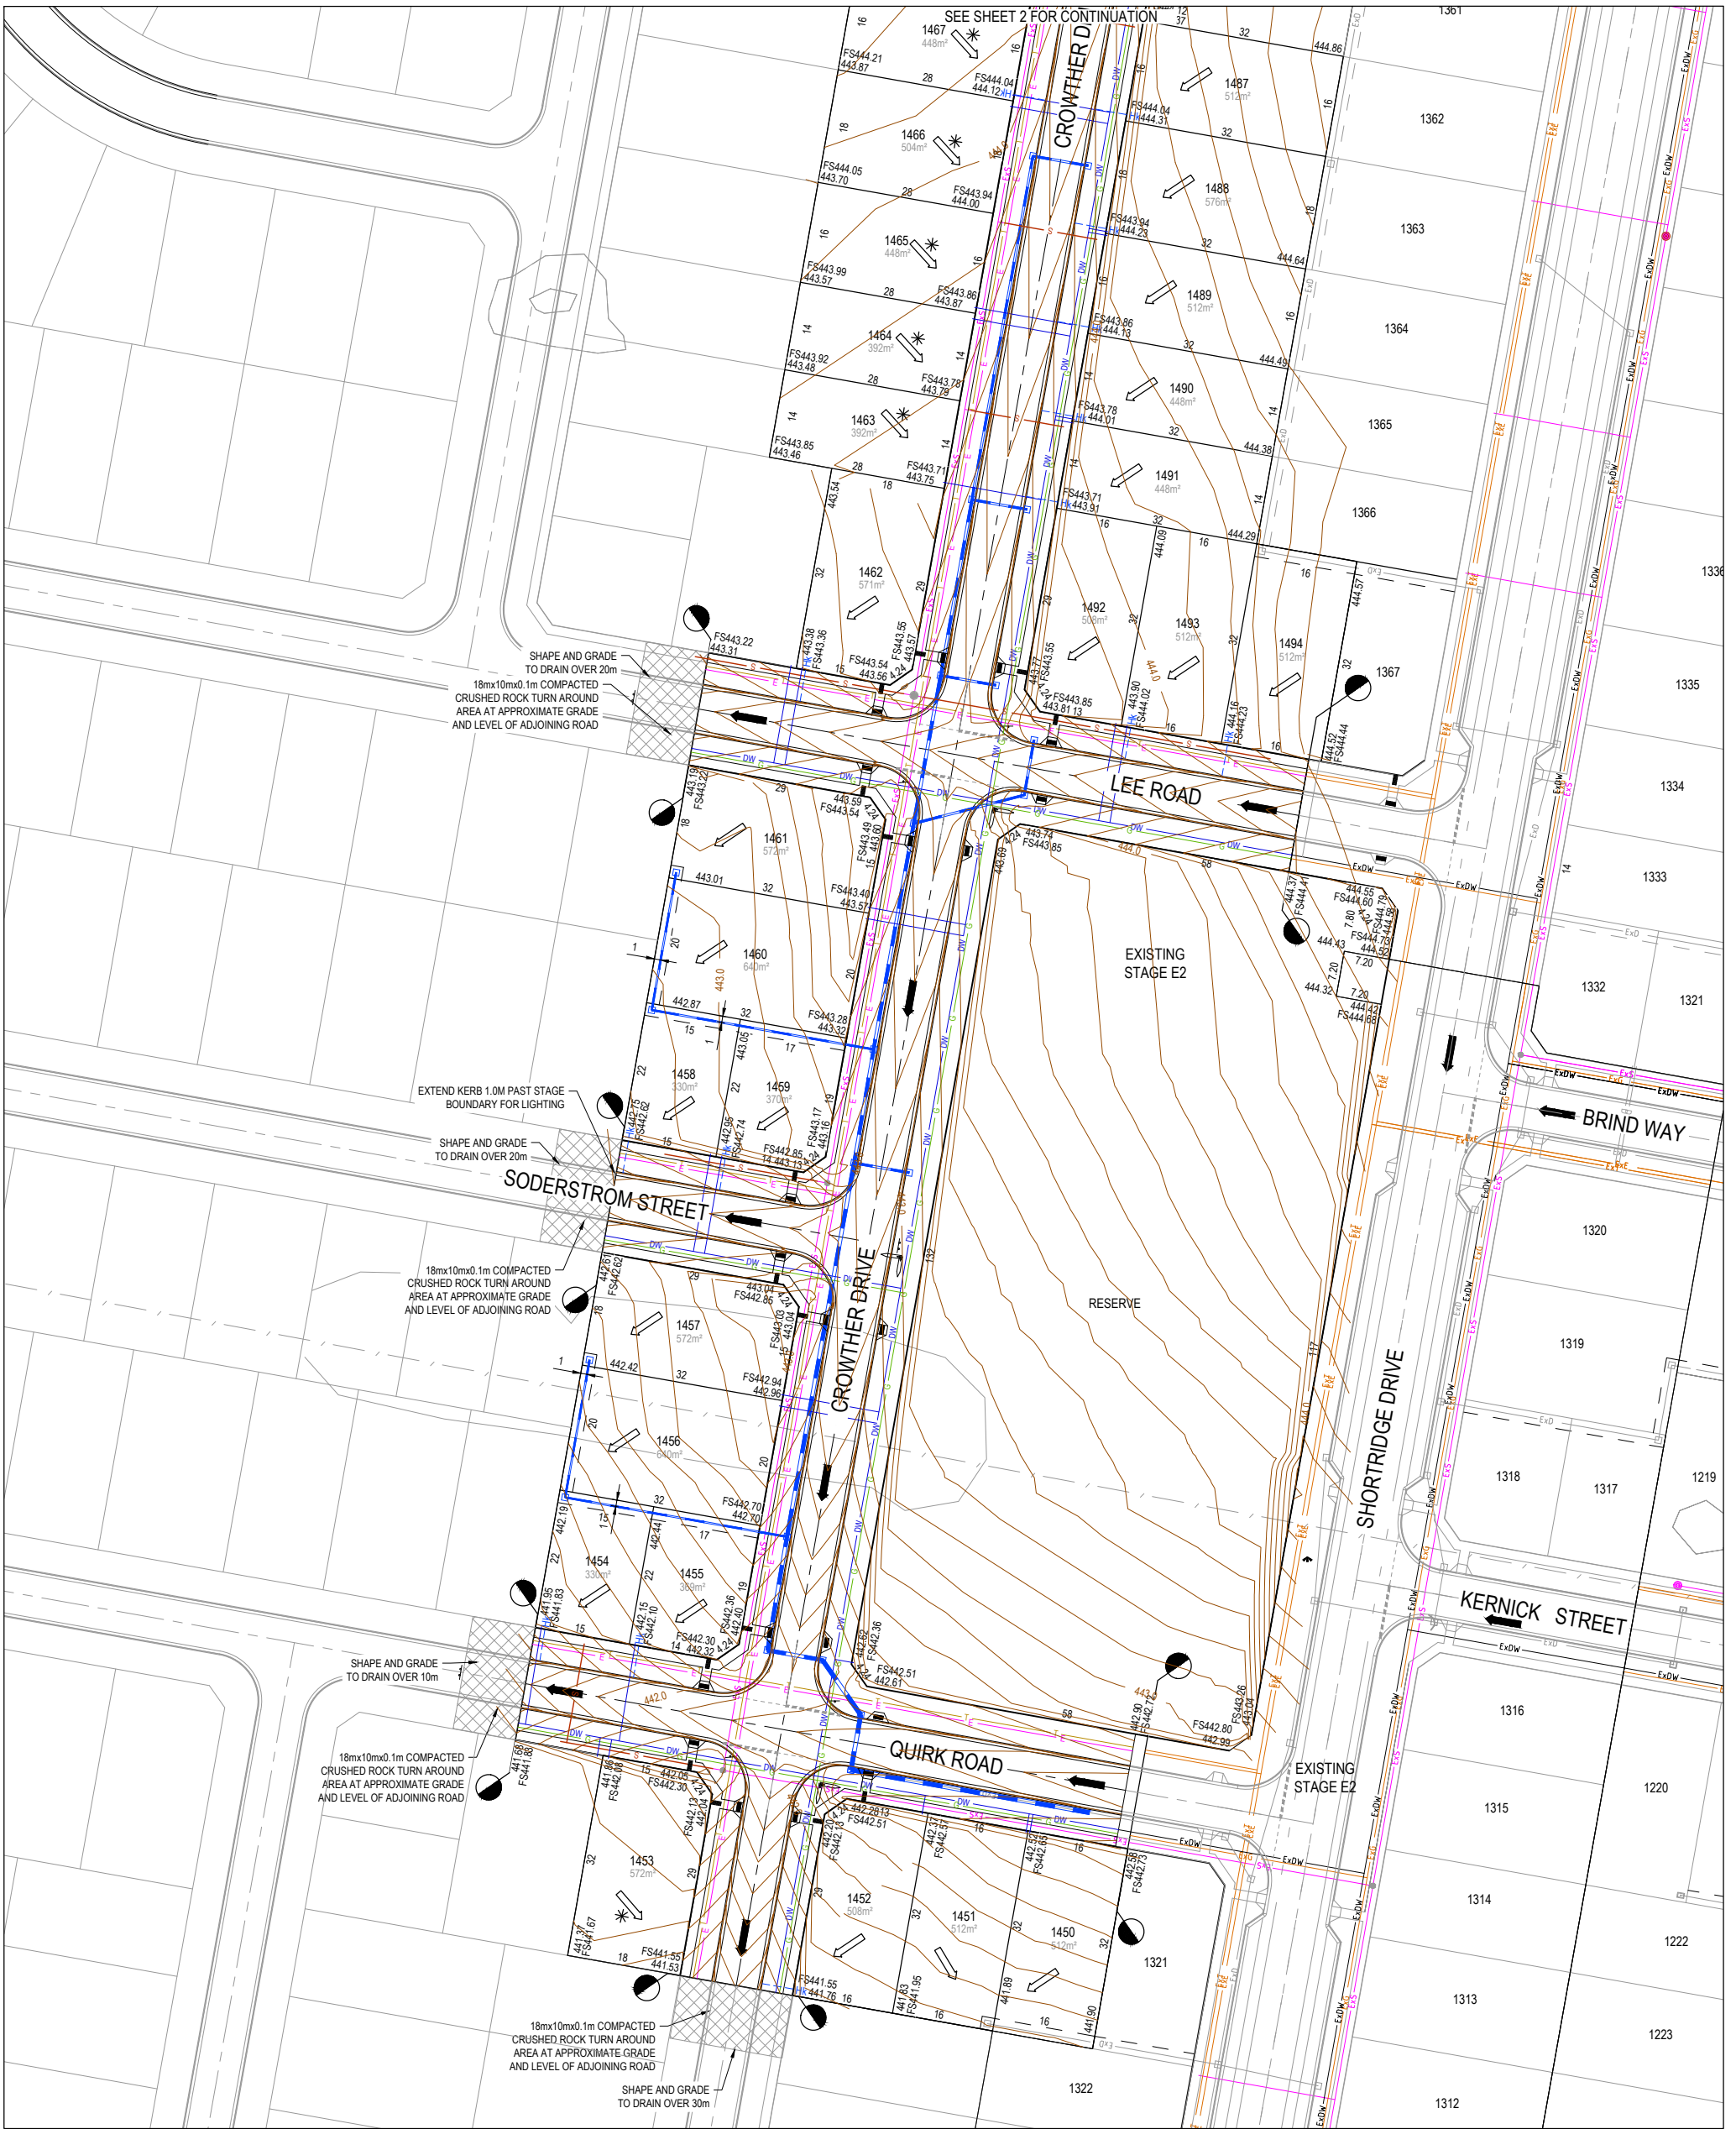

**LEGEND - LAYOUT PLAN**

- Stormwater drain, pit & property inlet
- Swale drain
- Sewer & maintenance structures
- House drain
- Service conduits
- Electricity (underground)
- Electricity (overhead)
- Optic fibre
- Telecommunications
- Gas
- Water
- Recycled water
- Existing stormwater drain
- Existing electricity (underground)
- Existing electricity (overhead)
- Existing gas
- Existing optic fibre
- Existing telecommunications
- Existing water
- Existing recycled water
- Existing sewer
- Existing house drain
- Existing swale drain
- Tactile pavers (indicative only)
- Existing surface level
- Finished building line level
- Finished ridge line level
- Top of retaining wall
- Bottom of retaining wall
- Ridge line
- Retaining wall
- Zero lot lines
- Pavement treatment
- Structural fill > 200mm deep
- Ex. structural fill > 200mm deep
- Direction of fall
- Overland flow
- Allotment to be graded evenly in
- Direction of fall to levels indicated
- Concrete edge strip with subsol drain
- "No road" sign & barrier
- Limit of works
- Existing tree to be removed
- Permanent survey mark
- Temporary bench mark
- Proposed driveway

**WARNING**  
**Beware of Underground Services**  
The locations of underground services are approximate only and their exact position should be proven on site.  
No guarantee is given that all existing services are shown.  
Locate all underground services before commencement of works  
**DIAL 1100 BEFORE YOU DIG**  
www.1100.com.au

**APPROVED**  
By Jeff Colb at 5:08 pm, May 13, 2020

**AS CONSTRUCTED PLANS**






**LEGEND - LAYOUT PLAN**

- STORMWATER DRAIN, PIT & PROPERTY INLET
- SEWER & MAINTENANCE STRUCTURES
- SERVICE CONDUITS
- ELECTRICITY (UNDERGROUND)
- ELECTRICITY (OVERHEAD)
- OPTIC FIBRE
- TELECOMMUNICATIONS
- GAS
- WATER
- RECYCLED WATER
- EXISTING STORMWATER DRAIN
- EXISTING ELECTRICITY (UNDERGROUND)
- EXISTING ELECTRICITY (OVERHEAD)
- EXISTING GAS
- EXISTING OPTIC FIBRE
- EXISTING TELECOMMUNICATIONS
- EXISTING WATER
- EXISTING RECYCLED WATER
- EXISTING SEWER
- EXISTING HOUSE DRAIN
- EXISTING SWALE DRAIN
- TACTILE PAVERS (INDICATIVE ONLY)
- EXISTING SURFACE LEVEL
- FINISHED BUILDING LINE LEVEL
- FINISHED RIDGE LINE LEVEL
- TOP OF RETAINING WALL
- BOTTOM OF RETAINING WALL
- RIDGE LINE
- RETAINING WALL
- ZERO LOT LINES
- PAVEMENT TREATMENT
- STRUCTURAL FILL > 200mm DEEP
- EX. STRUCTURAL FILL > 200mm DEEP
- DIRECTION OF FALL
- OVERLAND FLOW
- ALLOTMENT TO BE GRADED EVENLY IN
- DIRECTION OF FALL TO LEVELS INDICATED
- CONCRETE EDGE STRIP WITH SUBSOIL DRAIN
- "NO ROAD" SIGN & BARRIER
- LIMIT OF WORKS
- EXISTING TREE TO BE REMOVED
- PERMANENT SURVEY MARK
- TEMPORARY BENCH MARK
- PROPOSED DRIVEWAY

**WARNING**  
**Beware of Underground Services**  
The locations of underground services are approximate only and their exact position should be proven on site. No guarantee is given that all existing services are shown. Locate all underground services before commencement of works.  
**DIAL 1100 BEFORE YOU DIG**  
www.1100.com.au

**APPROVED**  
By Jeff Colb at 5:09 pm, May 13, 2020

**AS CONSTRUCTED PLANS**

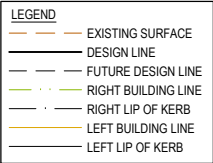


**APPROVED**  
By JeffColb at 5:09 pm, May 13, 2020

Sheet 07 of 26

Project Ref	Stage No	Drawing No	Rev
-------------	----------	------------	-----

LEGEND	
	EXISTING SURFACE
	DESIGN LINE
	FUTURE DESIGN LINE
	RIGHT BUILDING LINE
	RIGHT LIP OF KERB
	LEFT BUILDING LINE
	LEFT LIP OF KERB

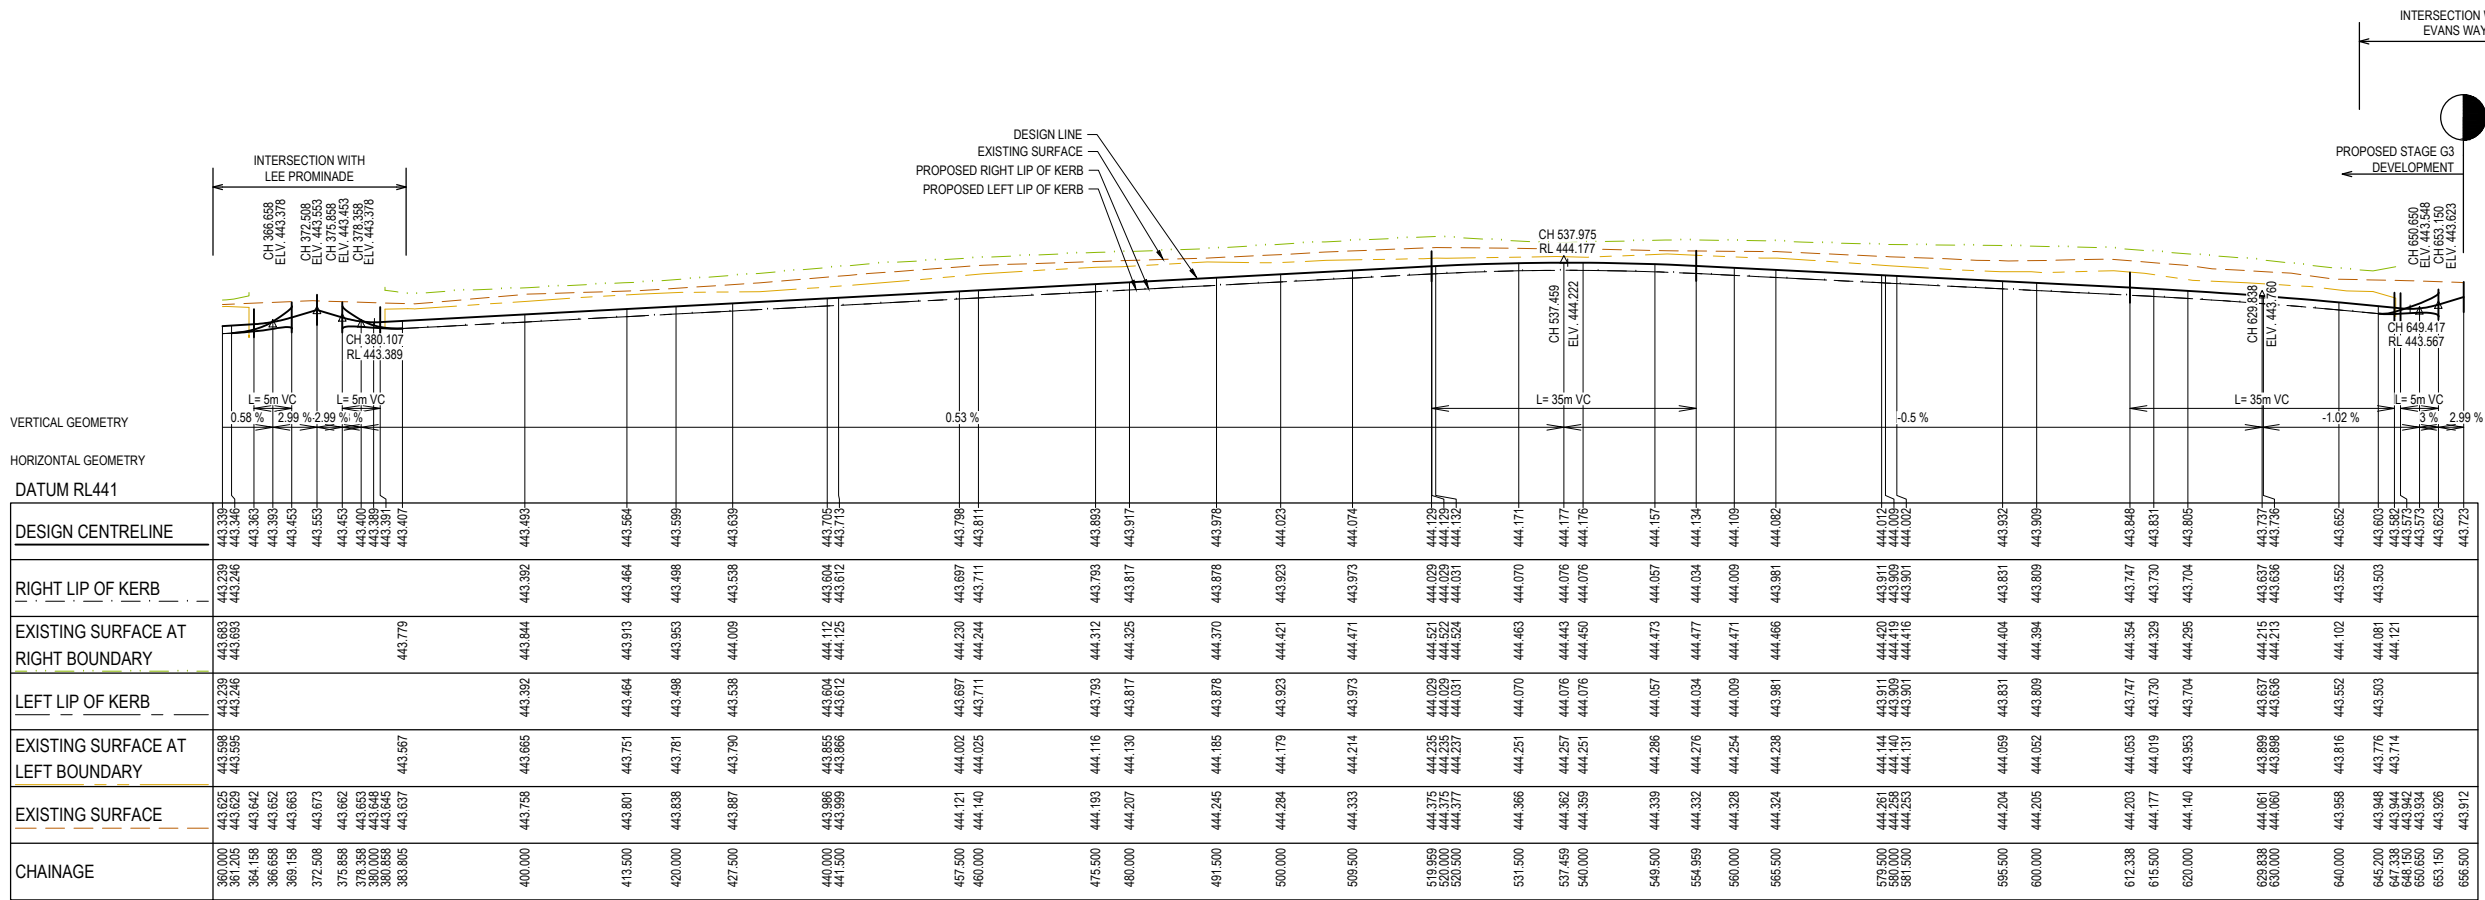


CROWTHER DRIVE LONGITUDINAL SECTION

**APPROVED**  
By Jeff Colb at 5:09 pm, May 13, 2020

AS CONSTRUCTED  
PLANS

© COPYRIGHT All rights reserved  
Beveridge Williams & Co. Pty Ltd has granted a licence to the principle to use this document for its intended purpose.  
No unauthorised copying is permitted

REV	DESCRIPTION	DATE	DRN.	APP.	REV	DESCRIPTION	DATE	DRN.	APP.
D	CAPPING LAYER DESCRIPTION CHANGE	24.10.19	TT	JS					
C	INTEGRA REVIEW	03.10.19	JS	JZ					
B	AMENDED DRAINAGE	28.08.19	TT	JS					
A	AMENDED AS PER COUNCIL COMMENTS	08.07.19	JS	JZ	F	AS CONSTRUCTED PLANS	13.05.20	TT	JS
P1	AMENDED AS PER INTEGRA COMMENTS	29.05.19	JS	JZ	E	SODERTROM PLACE TO SODER STROM STREET	06.02.20	TT	JS

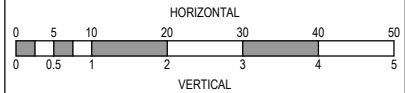

Designed Date	J.SPARK 29.01.19
Drawn	J.SPARK
Approved Date	J.ZAAL 29.01.19
PS Number	PS825912E




Project Details	LUCAS STAGE G3 CITY OF BALLARAT
Drawing Title	CROWTHER DRIVE LONGITUDINAL SECTIONS (SHEET 2 OF 6)

Sheet 08 of 26

Scale  
1:500 H 1:50 V @ A1

Project Ref	Stage No	Drawing No	Rev
1800971	G3	101	F



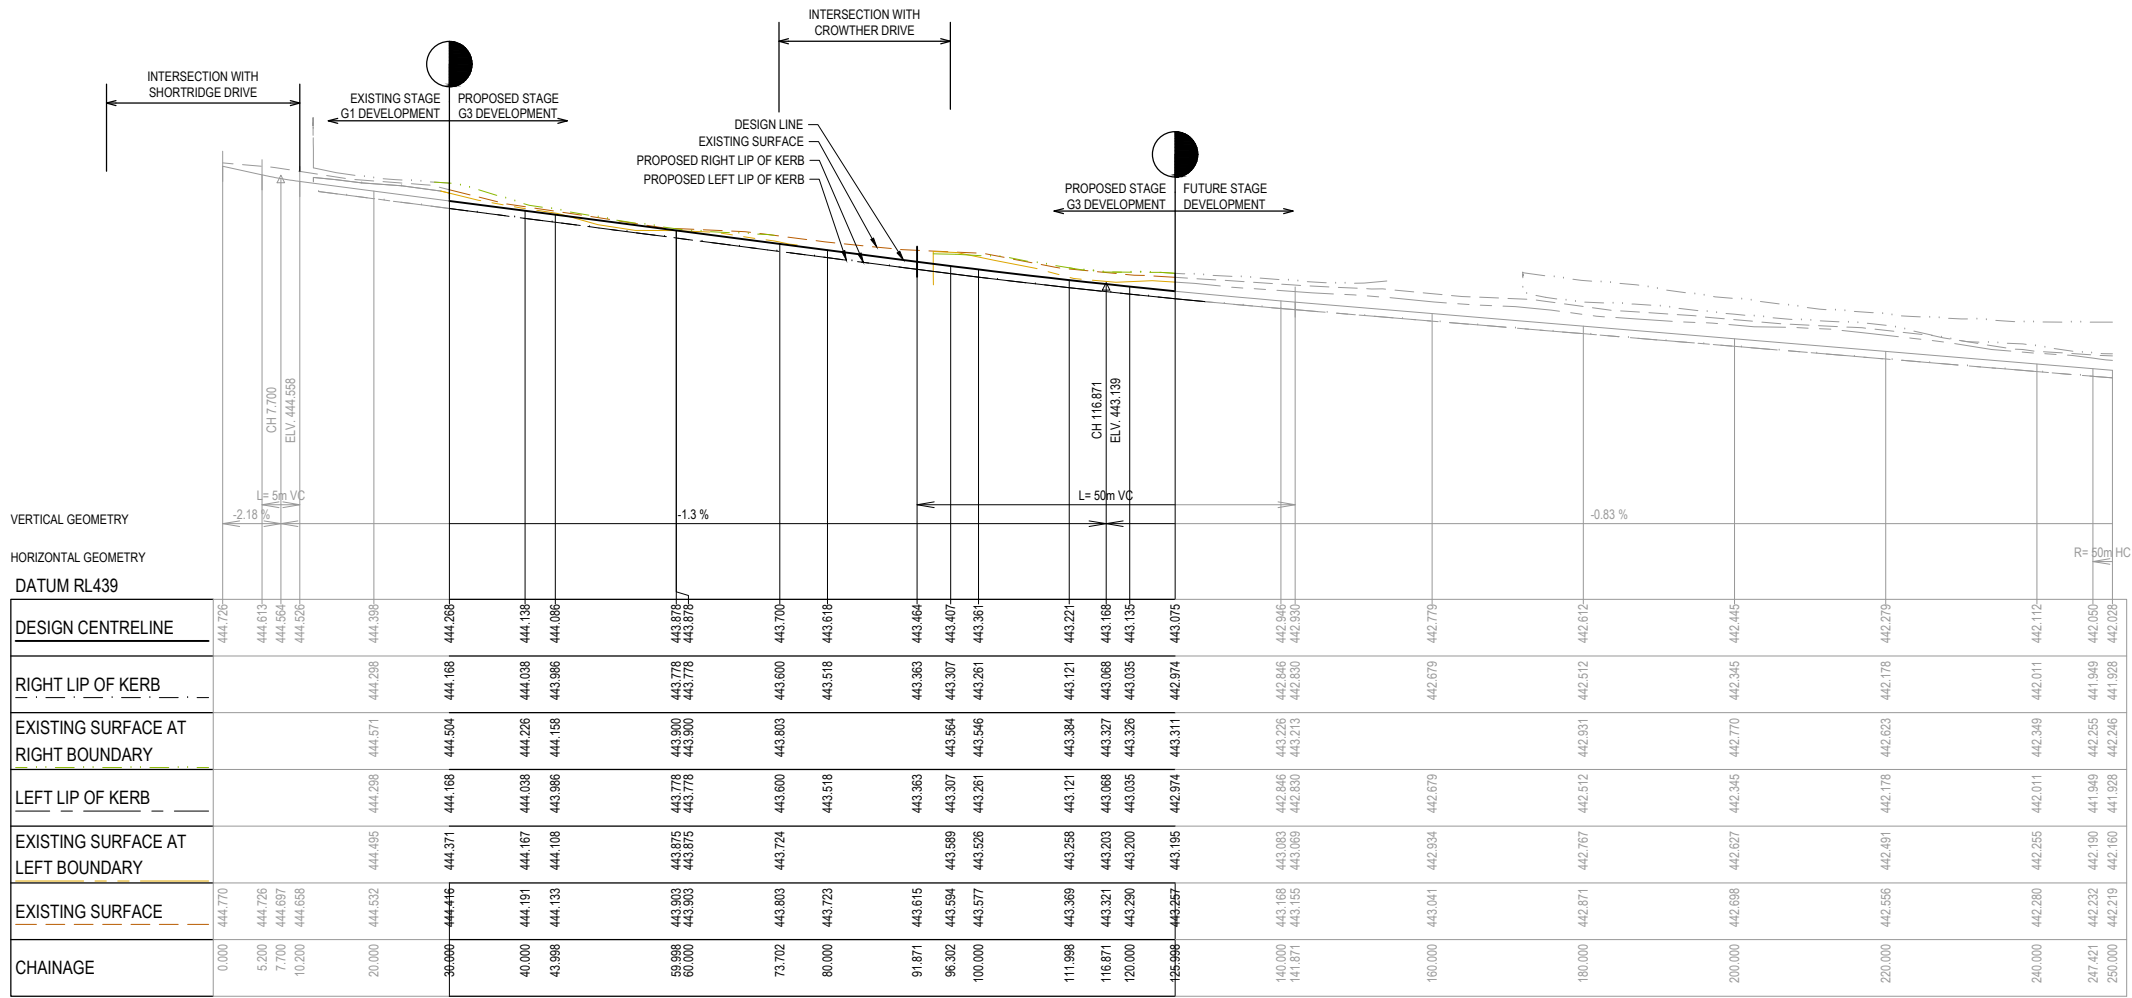


LEE ROAD LONGITUDINAL SECTION

**APPROVED**  
By JeffColb at 5:09 pm, May 13, 2020

AS CONSTRUCTED  
PLANS

© COPYRIGHT All rights reserved  
Beveridge Williams & Co. Pty Ltd has granted a licence to the principle to use this document for its intended purpose.  
No unauthorised copying is permitted

D	CAPPING LAYER DESCRIPTION CHANGE	24.10.19	TT	JS																										
C	INTEGRA REVIEW	03.10.19	JS	JZ																										
B	AMENDED DRAINAGE	28.08.19	TT	JS																										
A	AMENDED AS PER COUNCIL COMMENTS	08.07.19	JS	JZ	F		AS CONSTRUCTED PLANS		13.05.20	TT	JS																			
P1	AMENDED AS PER INTEGRA COMMENTS	29.05.19	JS	JZ	E		SODERDROM PLACE TO SODER STROM STREET		06.02.20	TT	JS																			
REV	DESCRIPTION	DATE	DRN.	APP.	REV		DESCRIPTION		DATE	DRN.	APP.																			

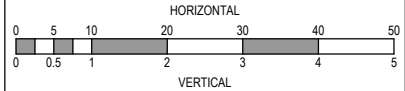

Designed  
Date J.SPARK  
29.01.19

Drawn  
J.SPARK

Approved  
Date J.ZAAL  
29.01.19

PS Number  
PS825912E



Beveridge Williams

96 Main Road  
Ballarat VIC 3350  
ph: 03 5327 2000  
www.beveridgewilliams.com.au

Project  
Details LUCAS  
STAGE G3  
CITY OF BALLARAT

Drawing  
Title LEE ROAD  
LONGITUDINAL SECTIONS (SHEET 3 OF 6)


Sheet 09 of 26

Scale  
1:500 H 1:50 V @ A1

Project Ref	Stage No	Drawing No	Rev
1800971	G3	102	F



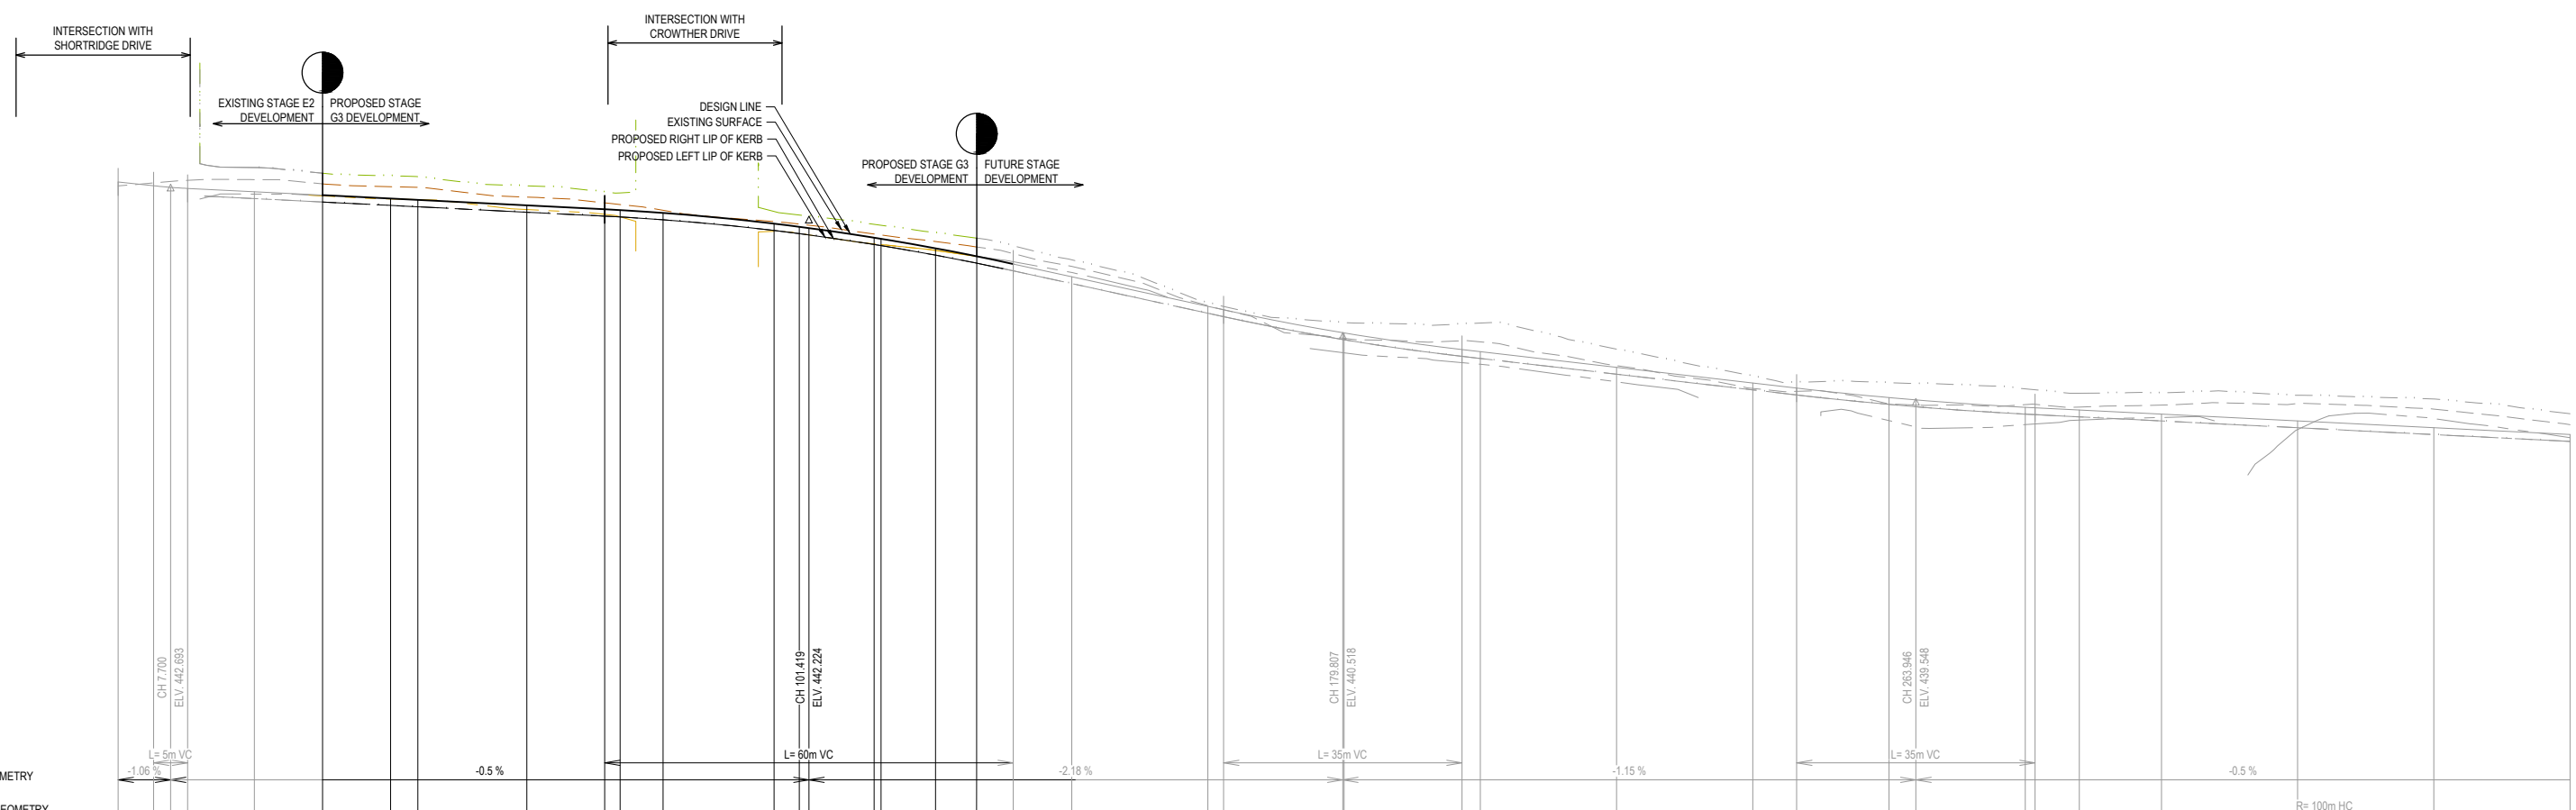


[illegible]

QUIRK ROAD LONGITUDINAL SECTION

**APPROVED**  
By JeffColb at 5:09 pm, May 13, 2020

AS CONSTRUCTED  
PLANS

COPYRIGHT All rights reserved Beveridge Williams & Co. Pty Ltd has granted a licence to the principle to use this document for its intended purpose. No unauthorised copying is permitted										Sheet 11 of 26									
D CAPPING LAYER DESCRIPTION CHANGE 24.10.19 TT JS C INTEGRA REVIEW 03.10.19 JS JZ B AMENDED DRAINAGE 28.08.19 TT JS A AMENDED AS PER COUNCIL COMMENTS 08.07.19 JS JZ F AS CONSTRUCTED PLANS 13.05.20 TT JS P1 AMENDED AS PER INTEGRA COMMENTS 29.05.19 JS JZ E SODERDTRON PLACE TO SODER STROM STREET 06.02.20 TT JS										Scale 1:500 H 1:50 V @ A1									
REV DESCRIPTION DATE DRN APP. REV DESCRIPTION DATE DRN APP.										Project Ref Stage No Drawing No Rev 1800971 G3 104 F									

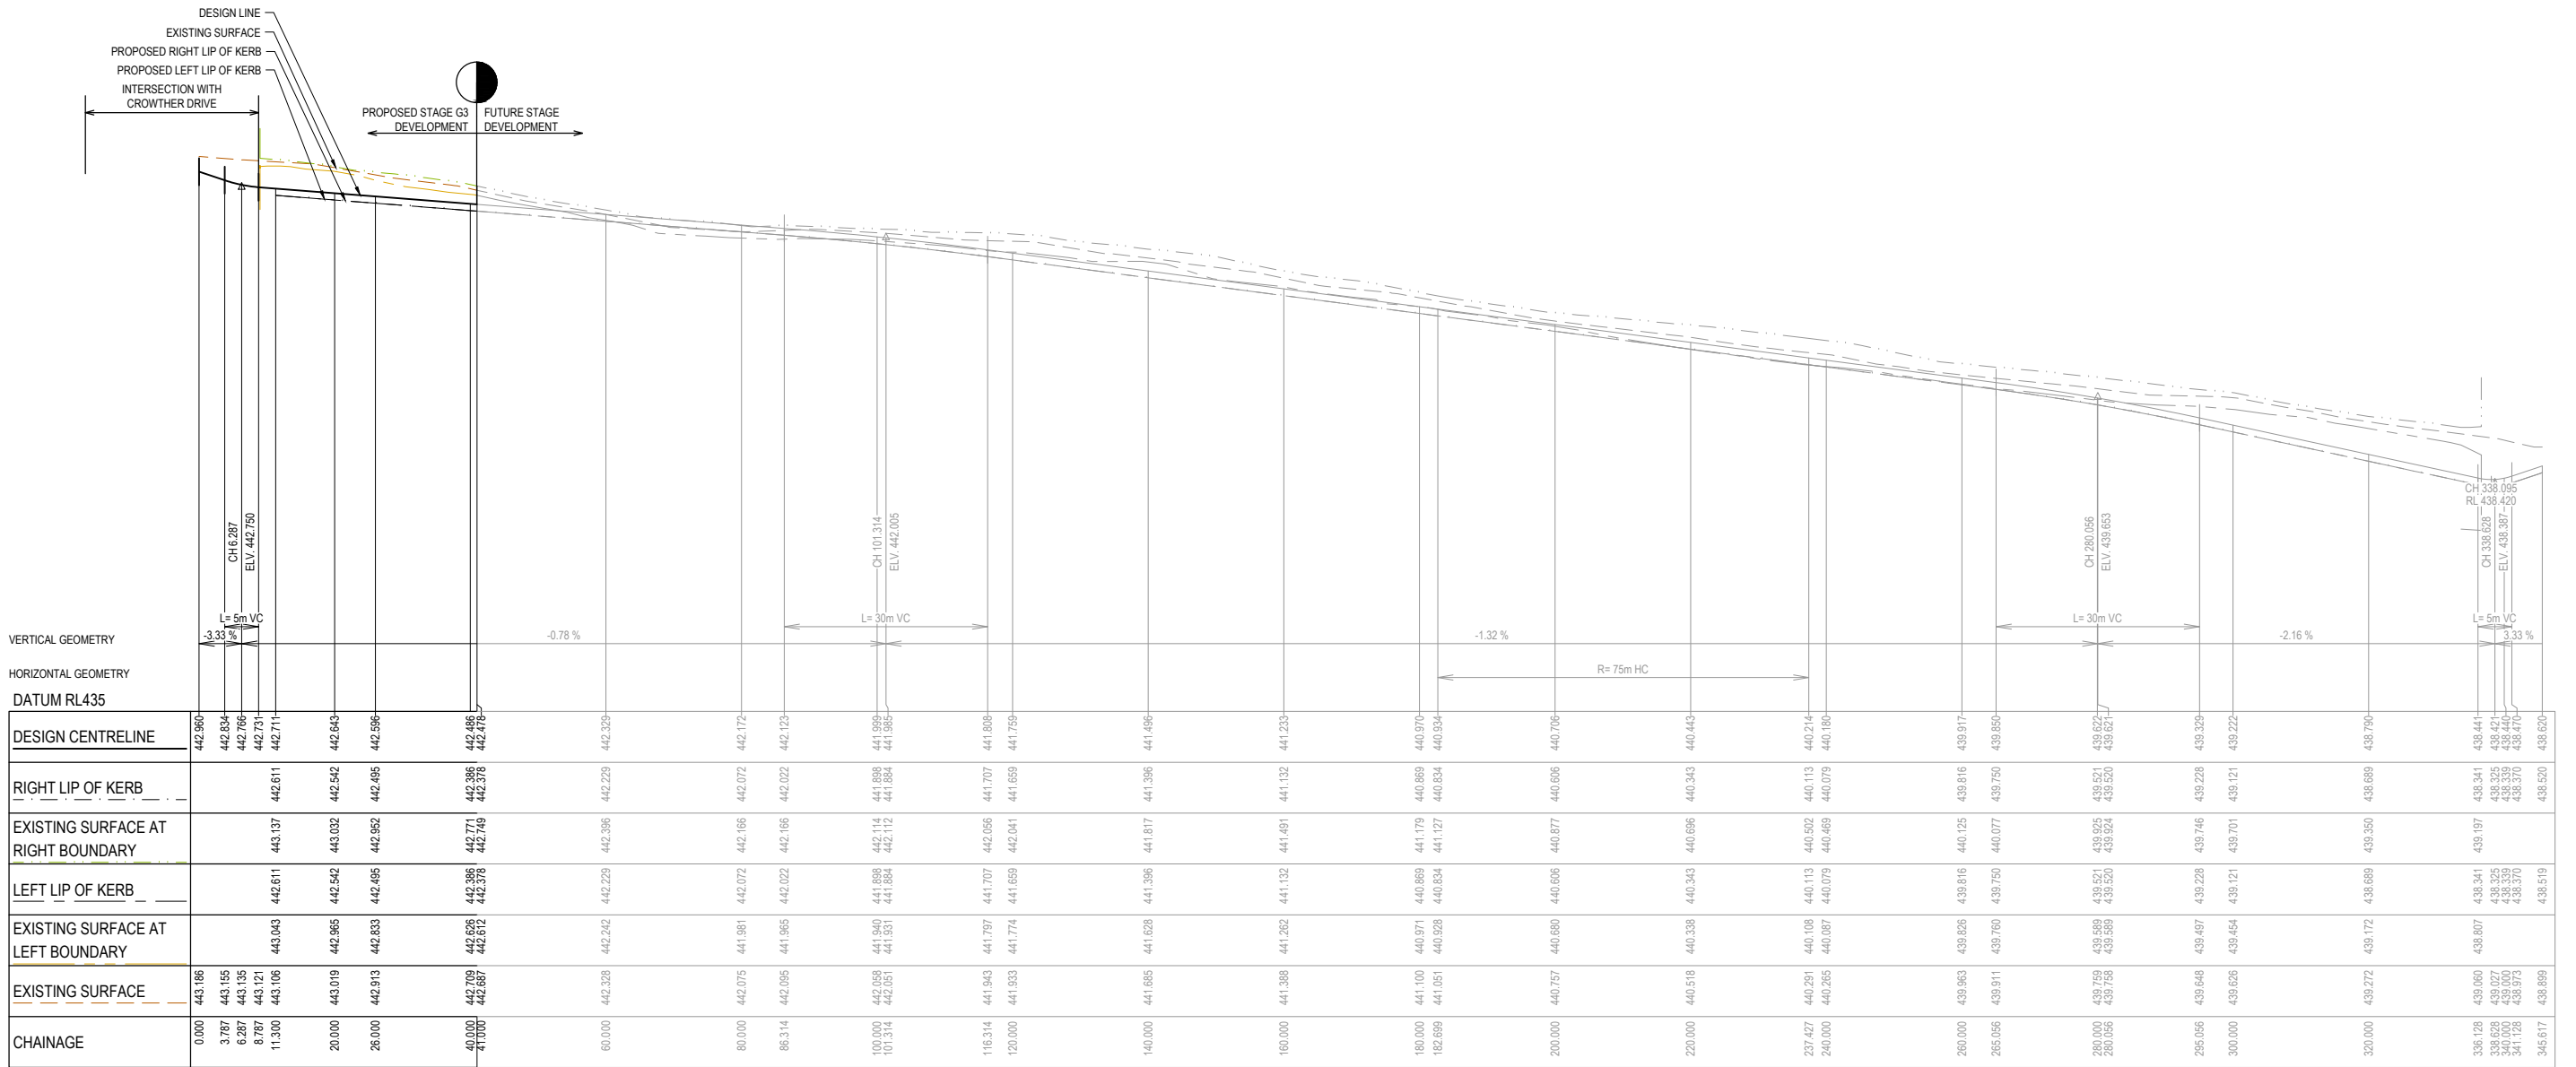


**APPROVED**  
By JeffColb at 5:10 pm, May 13, 2020

Sheet 12 of 26

Scale  
1:500 H 1:50 V @ A

Project Ref	Stage No	Drawing No	Rev
1800971	G3	105	F

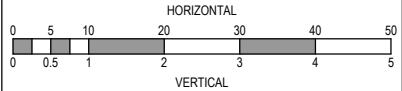[illegible]

Designed	J.SPARK
Date	29.01.19
Drawn	J.SPARK
Approved	J.ZAAL
Date	29.01.19
PS Number	PS825912E



**Beveridge Williams**  
96 Main Road  
Ballarat Vic 3350  
ph: 03 5327 2000  
[www.beveridgewilliams.com.au](http://www.beveridgewilliams.com.au)


Project  
Details

LUCAS  
STAGE G3  
CITY OF BALLARAT


Drawing Title  
SODERSTROM STREET  
LONGITUDINAL SECTIONS (SHEET 6 OF 6)




STRUCTURAL FILL REQUIRED UNDER PAVEMENT AND FOOTPATHS WHERE CONSTRUCTED ABOVE NATURAL SURFACE. REFER GEOTECH REPORT FOR SPECIFICATION

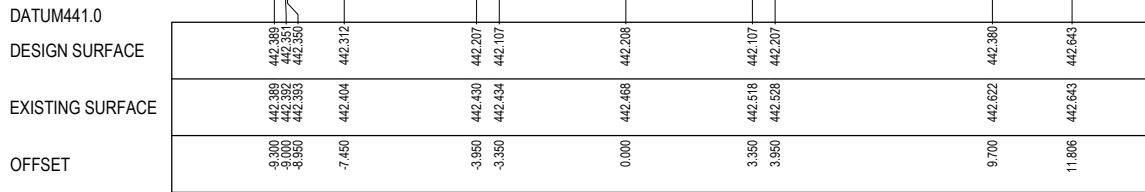


CH 227.800

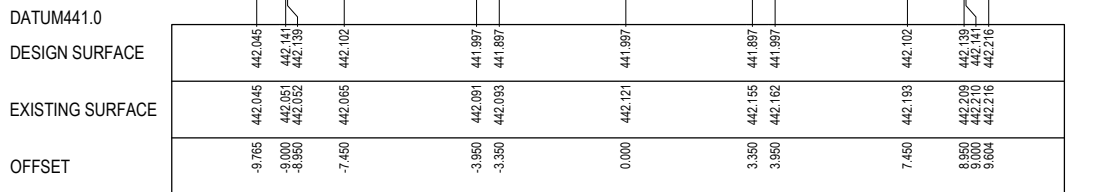


CH 205.200

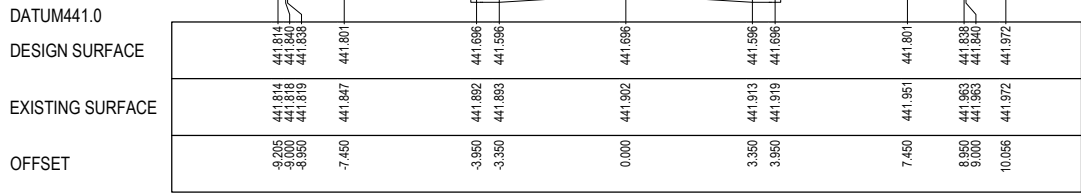


CH 190.000

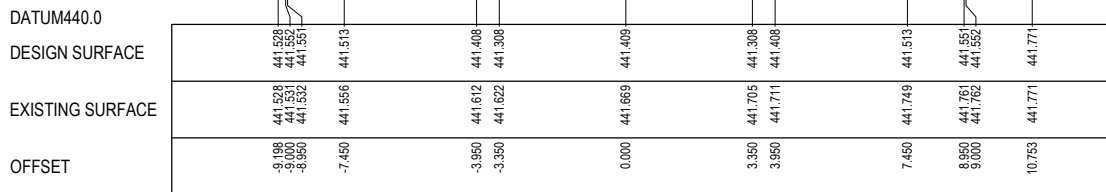


CH 175.500

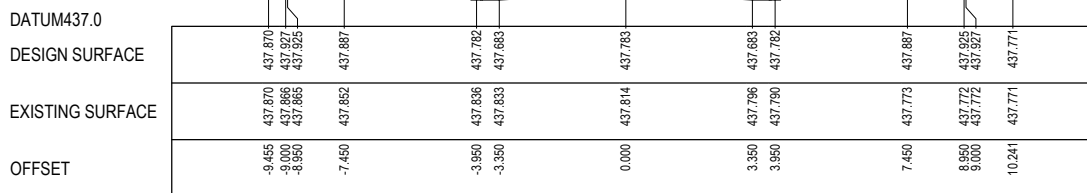


CH 0.000

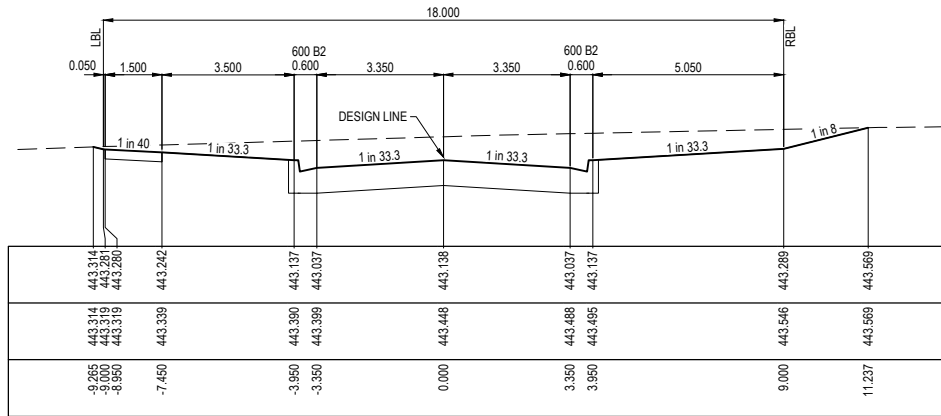


CH 325.500

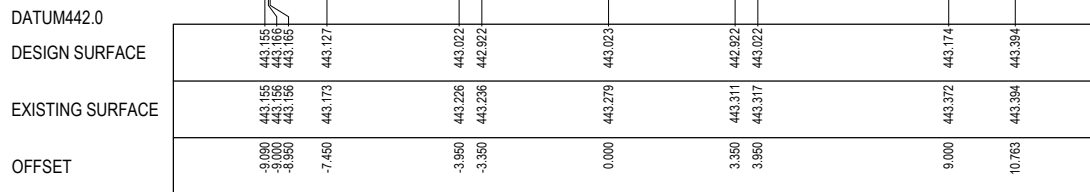


CH 305.800

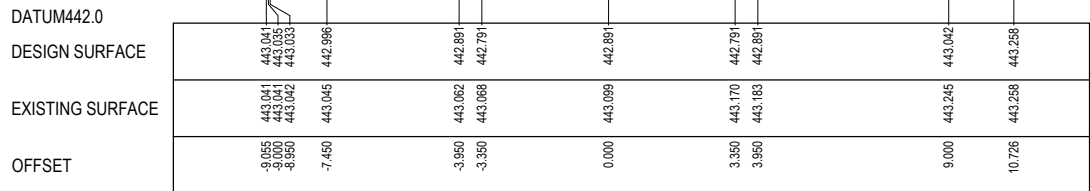


CH 283.200

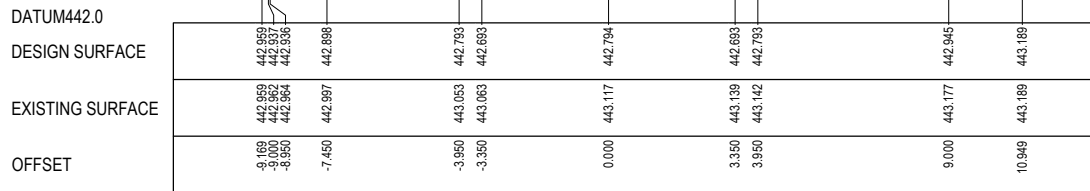

CH 267.500

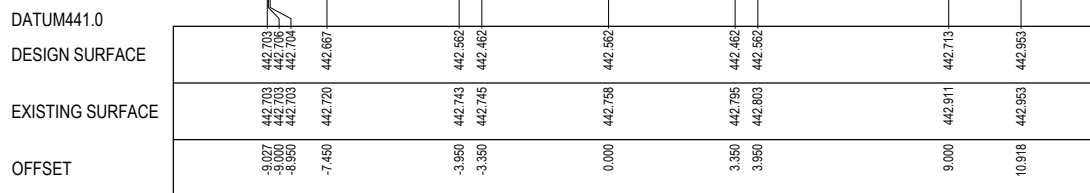

CH 247.500

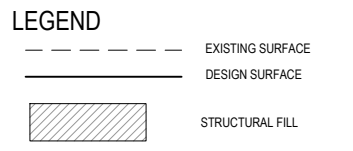


APPROVED  
By JeffColb at 5:10 pm, May 13, 2020

AS CONSTRUCTED  
PLANS

© COPYRIGHT All rights reserved  
Beveridge Williams & Co. Pty Ltd has granted a licence to the principle to use this document for its intended purpose.  
No unauthorised copying is permitted

REV	DESCRIPTION	DATE	DRN.	APP.	REV	DESCRIPTION	DATE	DRN.	APP.
D	CAPPING LAYER DESCRIPTION CHANGE	24.10.19	TT	JS					
C	INTEGRA REVIEW	03.10.19	JS	JZ					
B	AMENDED DRAINAGE	28.08.19	TT	JS					
A	AMENDED AS PER COUNCIL COMMENTS	08.07.19	JS	JZ	F	AS CONSTRUCTED PLANS	13.05.20	TT	JS
P1	AMENDED AS PER INTEGRA COMMENTS	29.05.19	JS	JZ	E	SODERDROM PLACE TO SODER STROM STREET	06.02.20	TT	JS

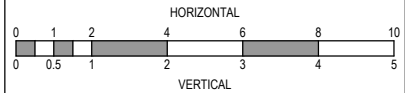

Designed  
Date  
29.01.19  
J.SPARK

Drawn  
J.SPARK

Approved  
Date  
29.01.19  
J.ZAAL

PS Number  
PS825912E

**BW** Beveridge Williams

96 Main Road  
Ballarat Vic 3350  
ph: 03 5327 2000  
www.beveridgewilliams.com.au

Project  
Details  
LUCAS  
STAGE G3  
CITY OF BALLARAT

Drawing  
Title  
CROWTHER DRIVE CROSS SECTIONS  
(SHEET 1 OF 7)

Sheet 13 of 26

Scale  
1:100 H 1:50 V @ A1

Project Ref  
1800971

Stage No  
G3

Drawing No  
200

Rev  
F

X:\18\1800971\_Lucas\_Eng\Stage G3\Drawings\1800971-G3-200-RXS.dwg














AS CONSTRUCTED  
PLANS

LEGEND

--- EXISTING SURFACE  
--- DESIGN SURFACE


STRUCTURAL FILL REQUIRED UNDER PAVEMENT  
AND FOOTPATHS WHERE CONSTRUCTED ABOVE  
NATURAL SURFACE. REFER GEOTECH REPORT  
FOR SPECIFICATION

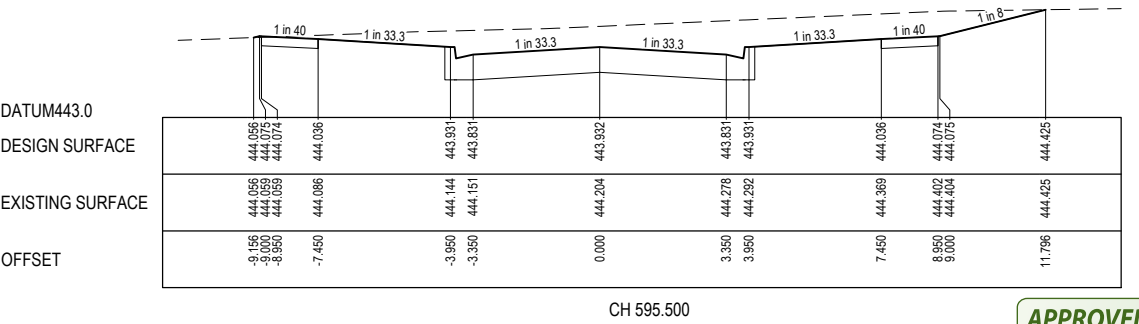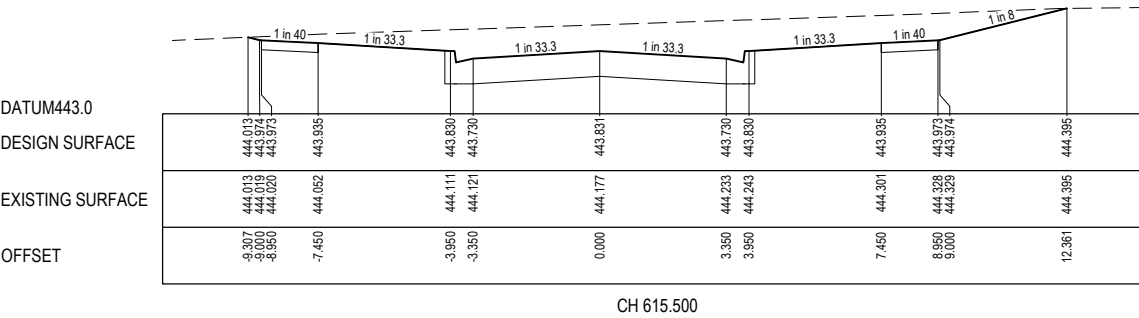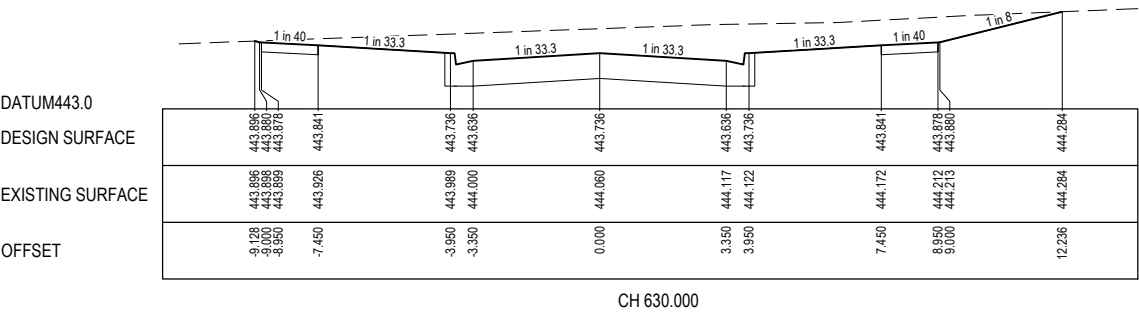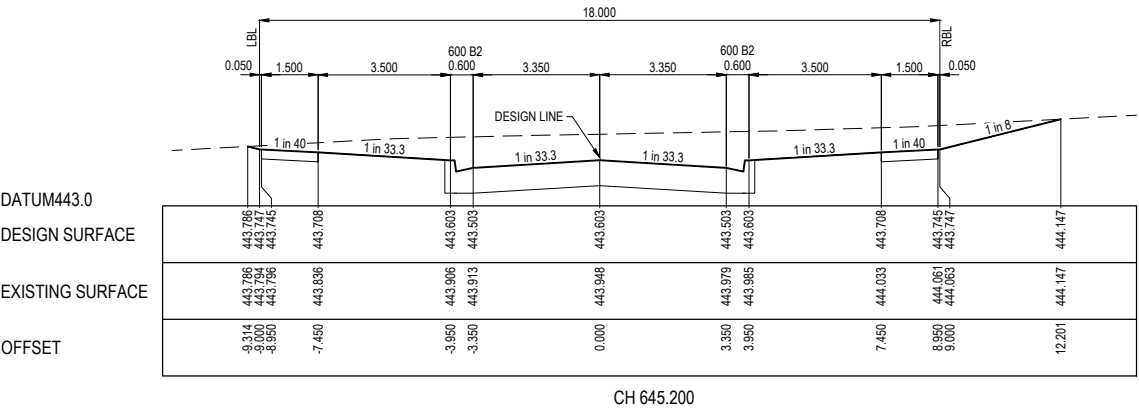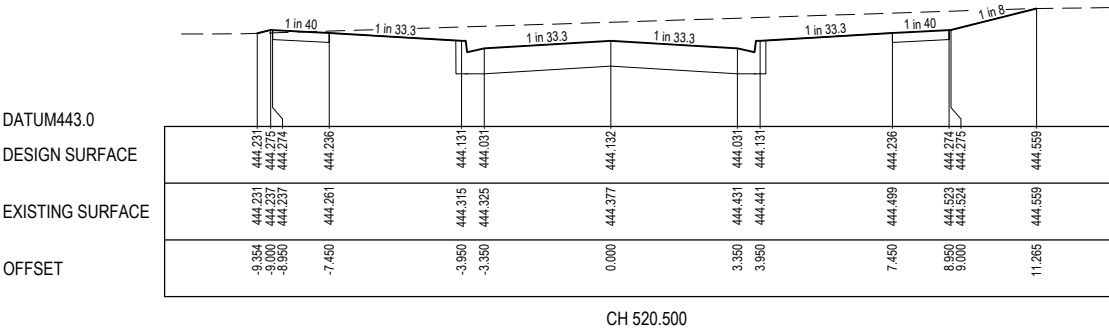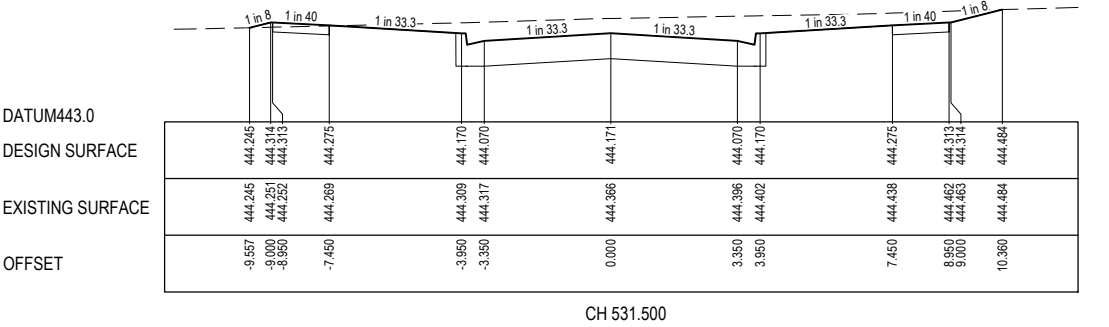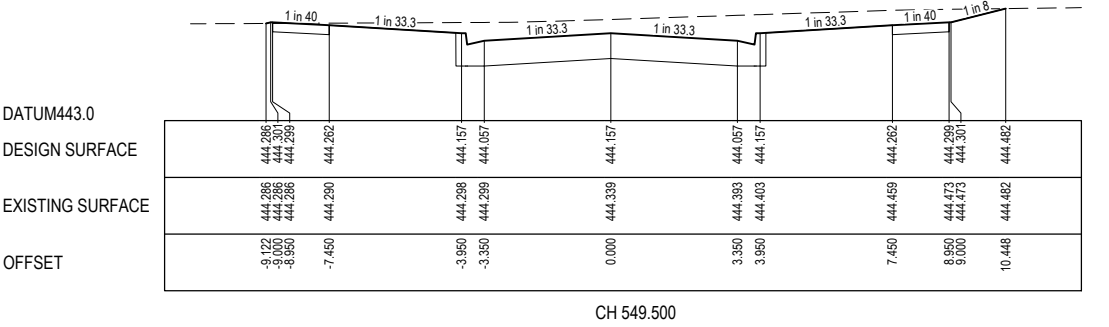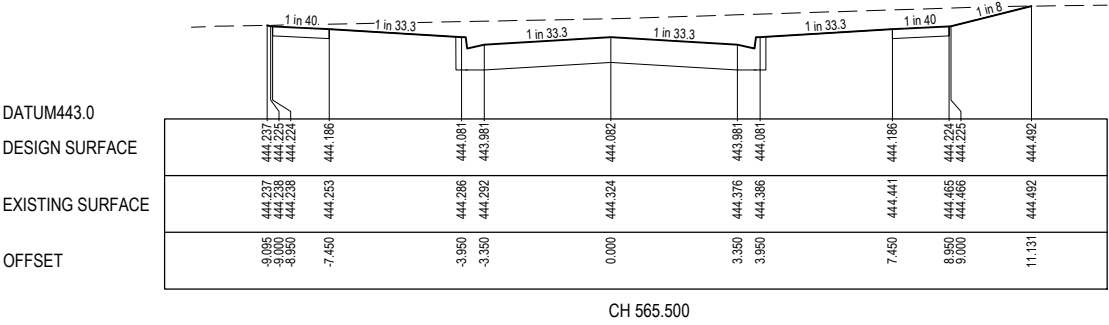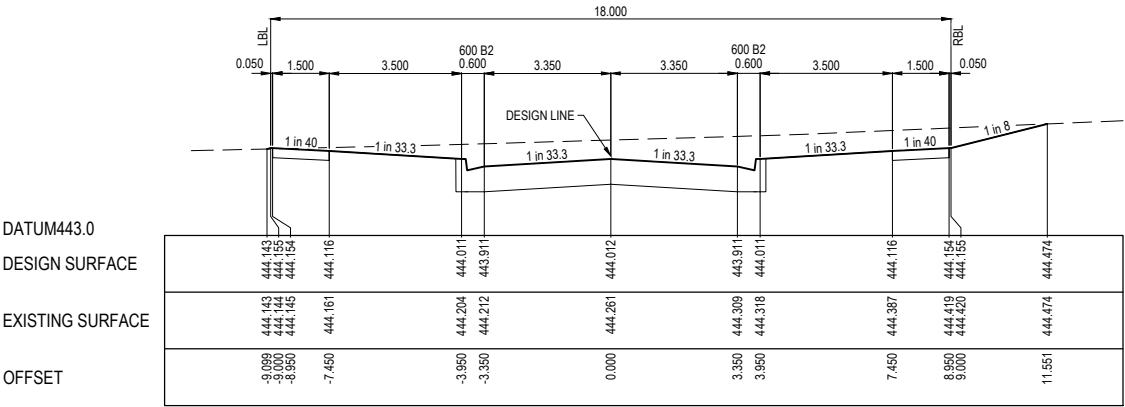

APPROVED  
By JeffColb at 5:10 pm, May 13, 2020

© COPYRIGHT All rights reserved  
Beveridge Williams & Co. Pty Ltd has granted a licence to the principle to use this document for its intended purpose.  
No unauthorised copying is permitted

D	CAPPING LAYER DESCRIPTION CHANGE	24.10.19	TT	JS						
C	INTEGRA REVIEW	03.10.19	JS	JZ						
B	AMENDED DRAINAGE	28.08.19	TT	JS						
A	AMENDED AS PER COUNCIL COMMENTS	08.07.19	JS	JZ	F	AS CONSTRUCTED PLANS	13.05.20	TT	JS	
P1	AMENDED AS PER INTEGRA COMMENTS	29.05.19	JS	JZ	E	SODERDROM PLACE TO SODER STROM STREET	06.02.20	TT	JS	
REV	DESCRIPTION	DATE	DRN.	APP.	REV	DESCRIPTION	DATE	DRN.	APP.	

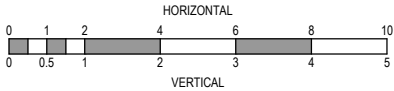

Designed  
Date

J.SPARK  
29.01.19

Drawn

J.SPARK

Approved  
Date

J.ZAAL  
29.01.19

PS Number

PS825912E



96 Main Road  
Ballarat VIC 3350  
ph: 03 5327 2000  
www.beveridgewilliams.com.au

Project  
Details

LUCAS  
STAGE G3  
CITY OF BALLARAT

Drawing  
Title

CROWTHER DRIVE CROSS SECTIONS  
(SHEET 3 OF 7)

Sheet 15 of 26

Scale  
1:100 H 1:50 V @ A1

Project Ref  
1800971








Stage No  
G3

Drawing No  
202

Rev  
F

STRUCTURAL FILL REQUIRED UNDER PAVEMENT AND FOOTPATHS WHERE CONSTRUCTED ABOVE NATURAL SURFACE. REFER GEOTECH REPORT FOR SPECIFICATION

LEGEND	
	EXISTING SURFACE
	DESIGN SURFACE

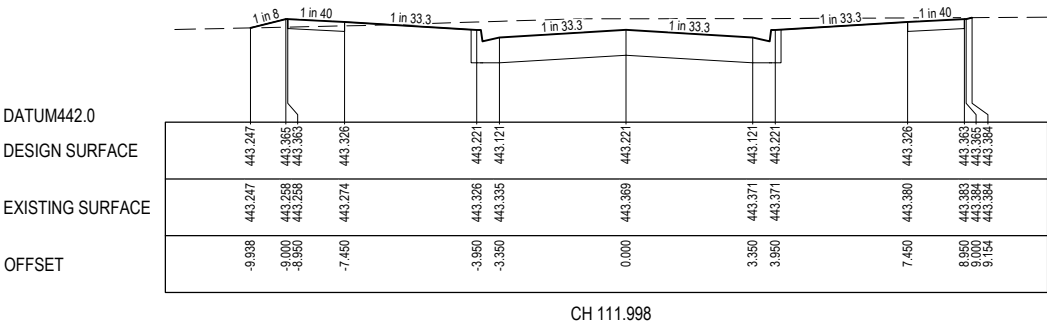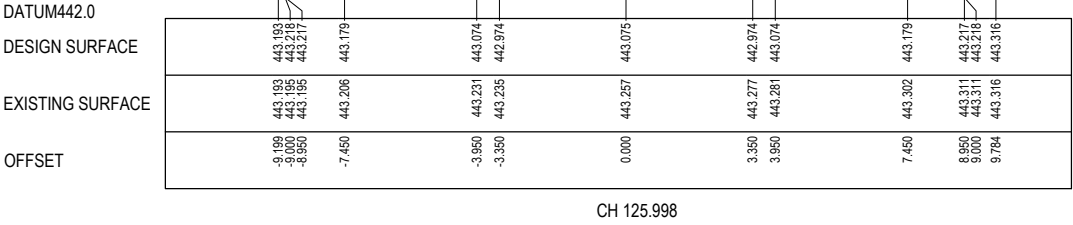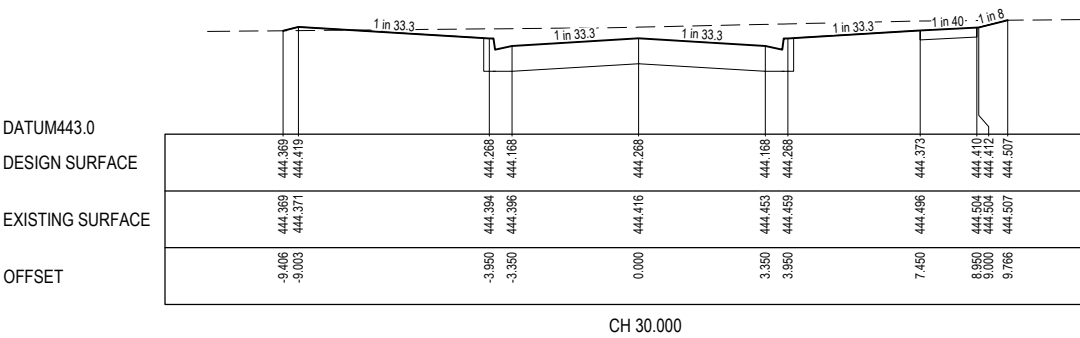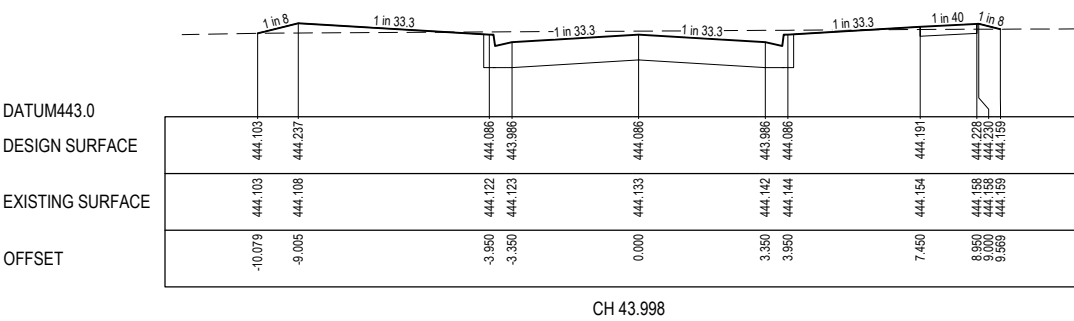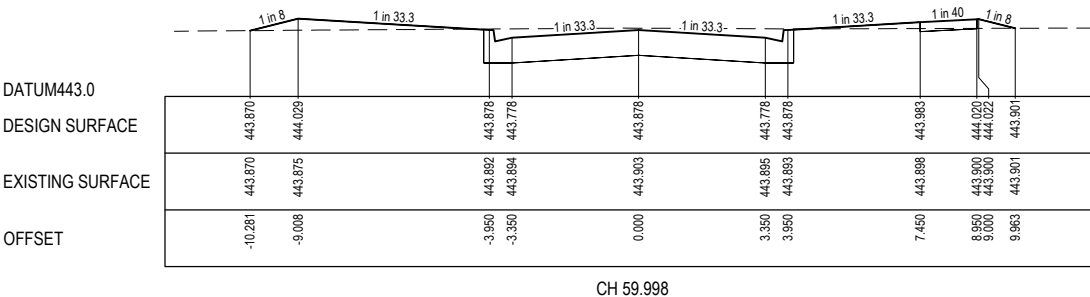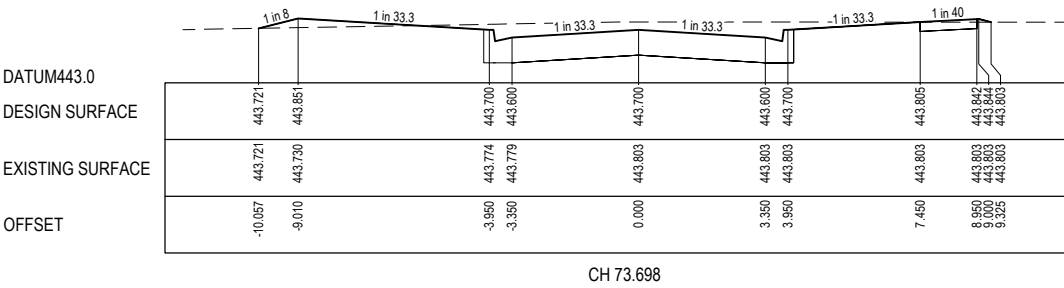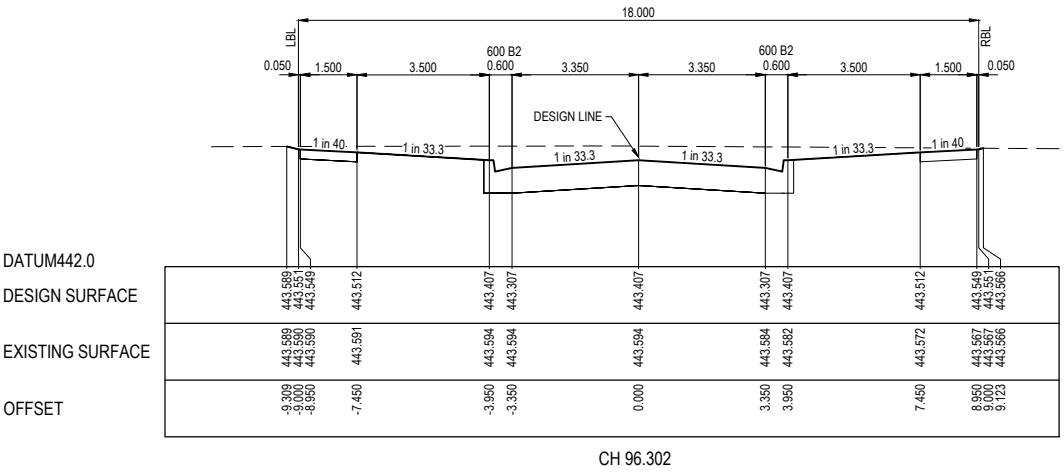


APPROVED  
By JeffColb at 5:10 pm, May 13, 2020

AS CONSTRUCTED  
PLANS

© COPYRIGHT All rights reserved  
Beveridge Williams & Co. Pty Ltd has granted a licence to the principle to use this document for its intended purpose.  
No unauthorised copying is permitted

REV	DESCRIPTION	DATE	DRN.	APP.	REV	DESCRIPTION	DATE	DRN.	APP.
D	CAPPING LAYER DESCRIPTION CHANGE	24.10.19	TT	JS					
C	INTEGRA REVIEW	03.10.19	JS	JZ					
B	AMENDED DRAINAGE	28.08.19	TT	JS					
A	AMENDED AS PER COUNCIL COMMENTS	08.07.19	JS	JZ	F	AS CONSTRUCTED PLANS	13.05.20	TT	JS
P1	AMENDED AS PER INTEGRA COMMENTS	29.05.19	JS	JZ	E	SODERDROM PLACE TO SODER STROM STREET	06.02.20	TT	JS

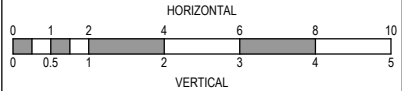

Designed Date	J.SPARK 29.01.19
Drawn	J.SPARK
Approved Date	J.ZAAL 29.01.19
PS Number	PS825912E



Project Details	LUCAS STAGE G3 CITY OF BALLARAT
Drawing Title	LEE ROAD CROSS SECTIONS (SHEET 4 OF 7)


Sheet 16 of 26

Scale  
1:100 H 1:50 V @ A1


Project Ref	Stage No	Drawing No	Rev
1800971	G3	203	F

X:\18\1800971 Lucas\_Eng\Stage G3\Drawings\1800971-G3-200-RXS.dwg

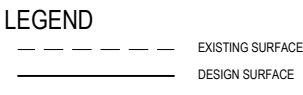


[illegible]

CH 112.000

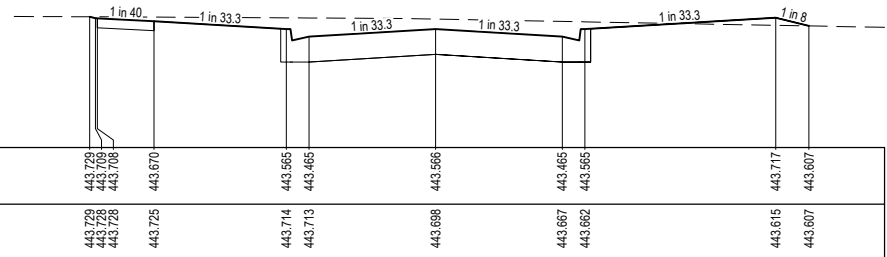


DATUM442.0	
DESIGN SURFACE	<div> <div>443.728</div> <div>443.728</div> <div>443.728</div> <div>443.670</div> </div>
EXISTING SURFACE	<div> <div>443.728</div> <div>443.728</div> <div>443.728</div> <div>443.725</div> </div>
OFFSET	<div> <div>9.153</div> <div>-3.000</div> <div>9.950</div> <div>-7.450</div> </div>
	<div> <div>3.950</div> <div>3.350</div> <div>0.000</div> <div>3.350</div> <div>3.950</div> </div>
	<div> <div>443.667</div> <div>443.662</div> <div>443.596</div> <div>443.596</div> <div>443.665</div> </div>
	<div> <div>9.000</div> <div>9.876</div> </div>

CH 96.300

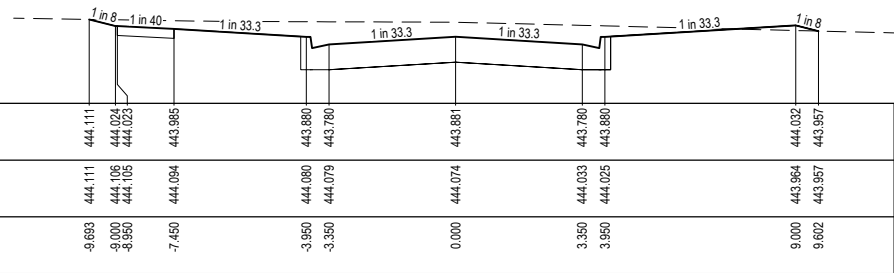


DATUM443.0															
DESIGN SURFACE		444.111	444.024	443.985		443.880	443.780	443.881		443.780			444.032		
EXISTING SURFACE		444.111	444.105	444.094		444.080	444.079	444.074		444.033	444.025		443.964		
OFFSET		-8.893	-9.000	-7.450		-3.950	-3.350	0.000		3.350	3.950		9.000		
		-8.950	-8.950										9.602		

CH 73.700

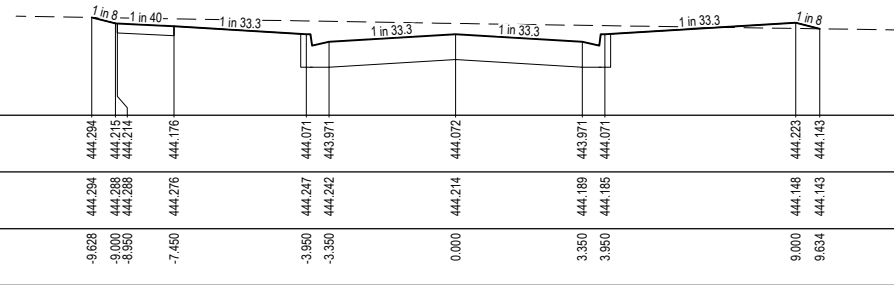
[illegible]

CH 60.000

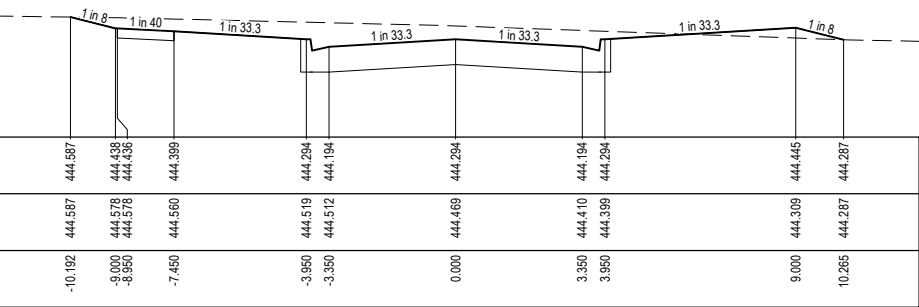

DATUM443.0	
DESIGN SURFACE	444.587 444.587 444.438 444.438
EXISTING SURFACE	444.587 444.578 444.578 444.578
OFFSET	-10.192 -8.000 -8.000 -7.450
	444.560 444.399 444.399 444.399
	444.294 444.294 444.194 444.194
	444.469 444.410 444.399 444.399
	444.445 444.287 444.287 444.287

CH 44.000

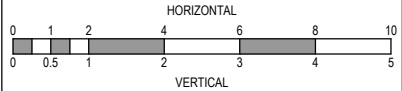[illegible]

Designed Date	J.SPARK 29.01.19
Drawn	J.SPARK
Approved Date	J.ZAAL 29.01.19
PS Number	PS825912E



Beveridge Williams

96 Main Road  
Ballarat Vic 3350  
ph: 03 5327 2000  
[www.beveridgewilliams.com.au](http://www.beveridgewilliams.com.au)

Project  
Details

LUCAS  
STAGE G3  
CITY OF BALLARAT

Drawing Title  
EVANS WAY CROSS SECTIONS  
(SHEET 5 OF 7)








**APPROVED**  
By JeffColb at 5:11 pm, May 13, 2020

AS CONSTRUCTED  
PLANS

Scale 1:100 H 1:50 V @ A1			
Project Ref	Stage No	Drawing No	Rev
1800971	G3	204	F

STRUCTURAL FILL REQUIRED UNDER PAVEMENT AND FOOTPATHS WHERE CONSTRUCTED ABOVE NATURAL SURFACE. REFER GEOTECH REPORT FOR SPECIFICATION


LEGEND  
- - - - - EXISTING SURFACE  
————— DESIGN SURFACE

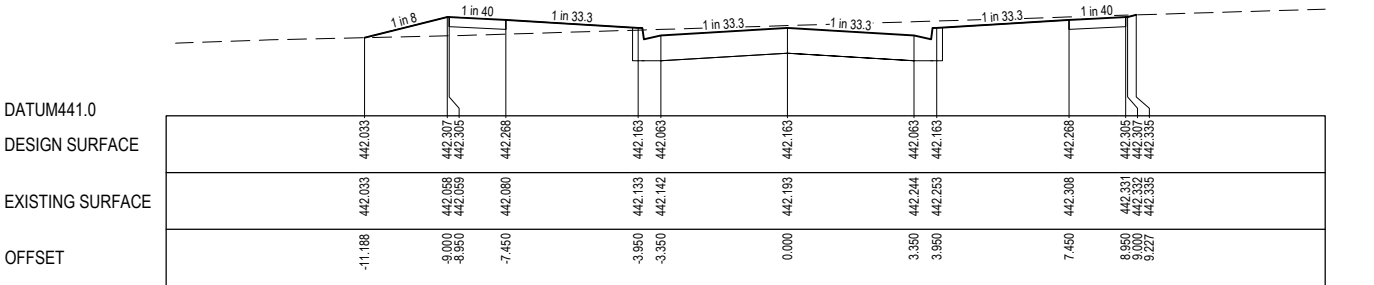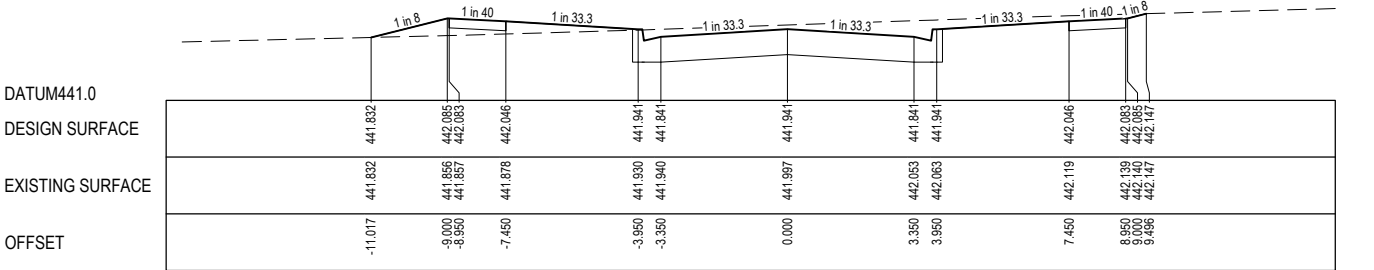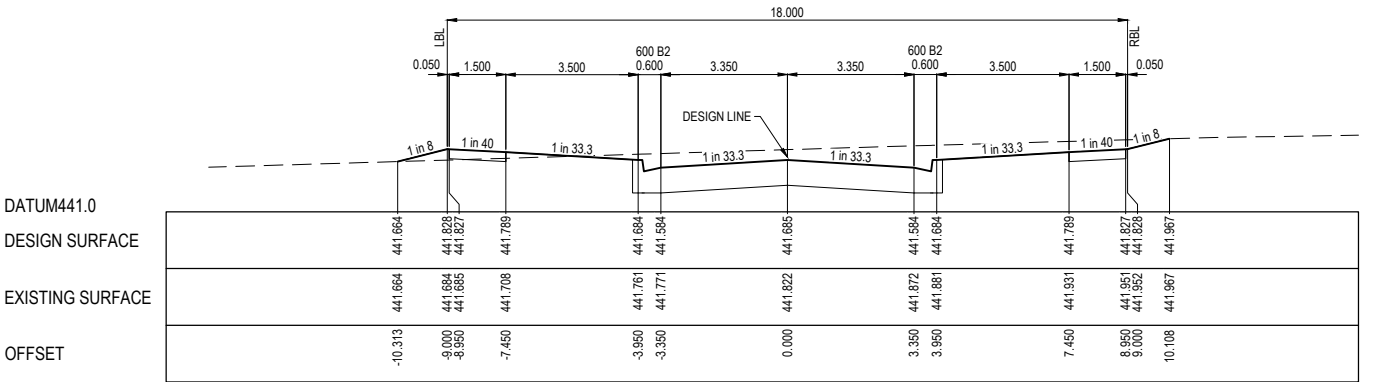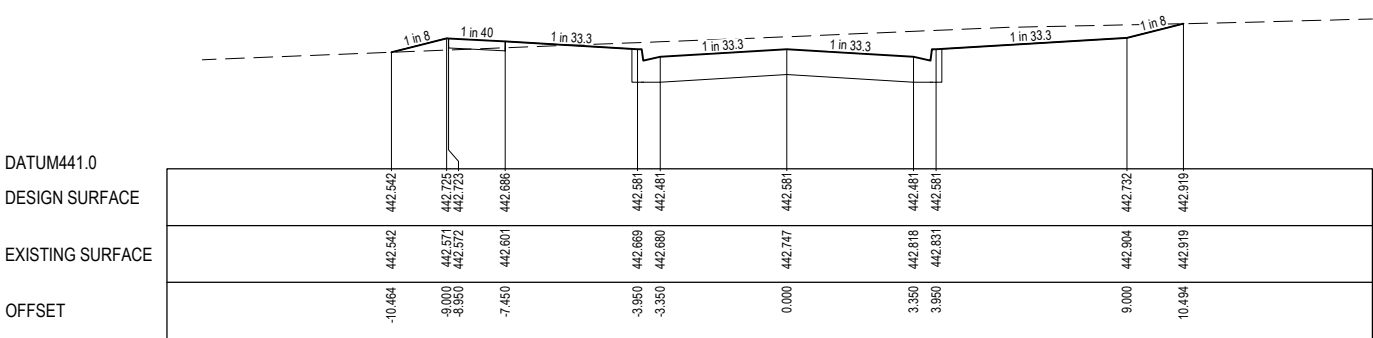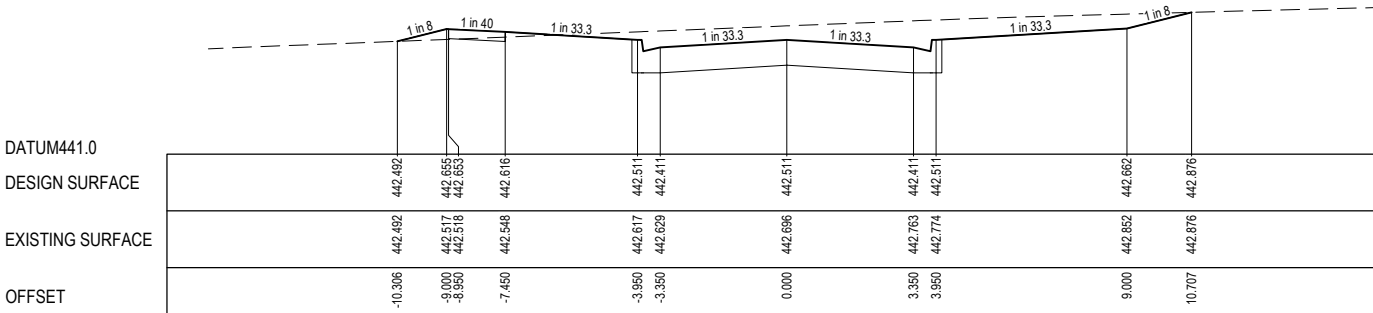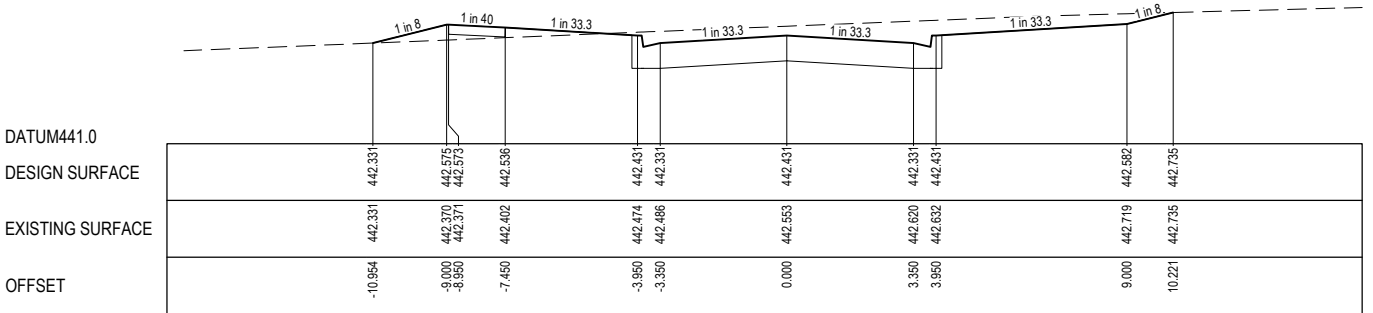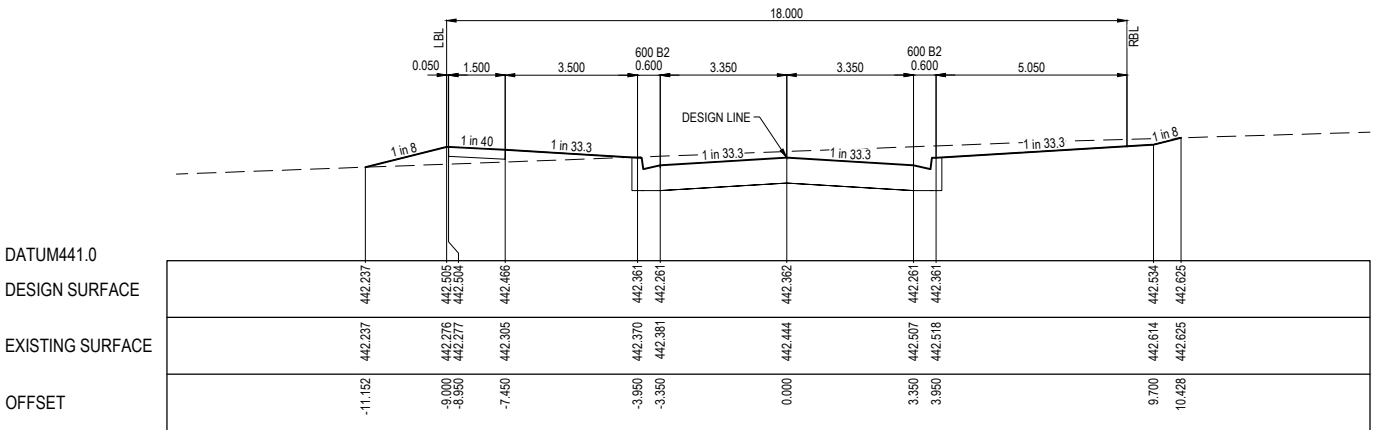

**APPROVED**  
By Jeff Colb at 5:11 pm, May 13, 2020

AS CONSTRUCTED  
PLANS

© COPYRIGHT All rights reserved Beveridge Williams & Co. Pty Ltd has granted a licence to the principle to use this document for its intended purpose. No unauthorised copying is permitted									
D	CAPPING LAYER DESCRIPTION CHANGE	24.10.19	TT	JS					
C	INTEGRA REVIEW	03.10.19	JS	JZ					
B	AMENDED DRAINAGE	28.08.19	TT	JS					
A	AMENDED AS PER COUNCIL COMMENTS	08.07.19	JS	JZ	F	AS CONSTRUCTED PLANS	13.05.20	TT	JS
P1	AMENDED AS PER INTEGRA COMMENTS	29.05.19	JS	JZ	E	SODERDROM PLACE TO SODER STROM STREET	06.02.20	TT	JS
REV	DESCRIPTION	DATE	DRN.	APP.	REV	DESCRIPTION	DATE	DRN.	APP.

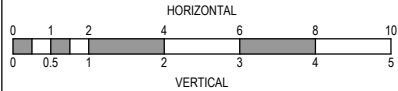

Designed  
Date J.SPARK  
29.01.19  
Drawn  
J.SPARK  
Approved  
Date J.ZAAL  
29.01.19  
PS Number  
PS825912E

**BW** Beveridge Williams  
96 Main Road  
Ballarat VIC 3350  
ph: 03 5327 2000  
www.beveridgewilliams.com.au

Project  
Details LUCAS  
STAGE G3  
CITY OF BALLARAT  
Drawing  
Title QUIRK ROAD CROSS SECTIONS  
(SHEET 6 OF 7)

Sheet 18 of 26

Scale  
1:100 H 1:50 V @ A1




Project Ref  
1800971  
Stage No  
G3  
Drawing No  
205  
Rev  
F

STRUCTURAL FILL REQUIRED UNDER PAVEMENT AND FOOTPATHS WHERE CONSTRUCTED ABOVE NATURAL SURFACE. REFER GEOTECH REPORT FOR SPECIFICATION

LEGEND

EXISTING SURFACE

DESIGN SURFACE

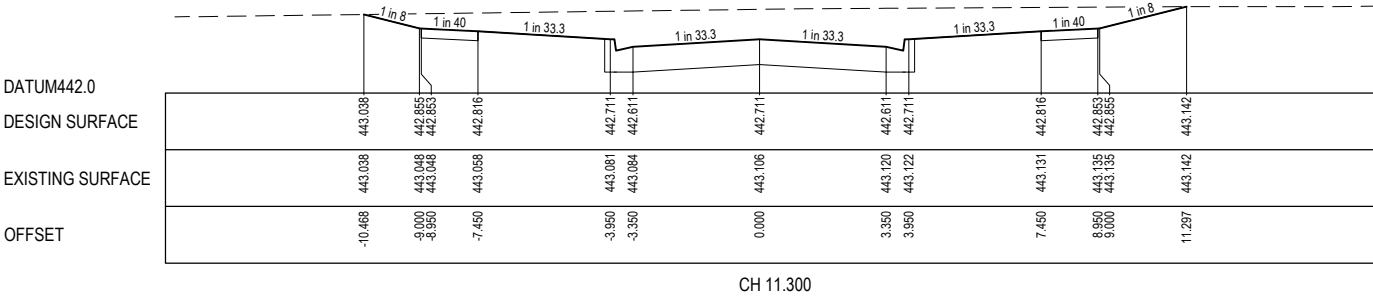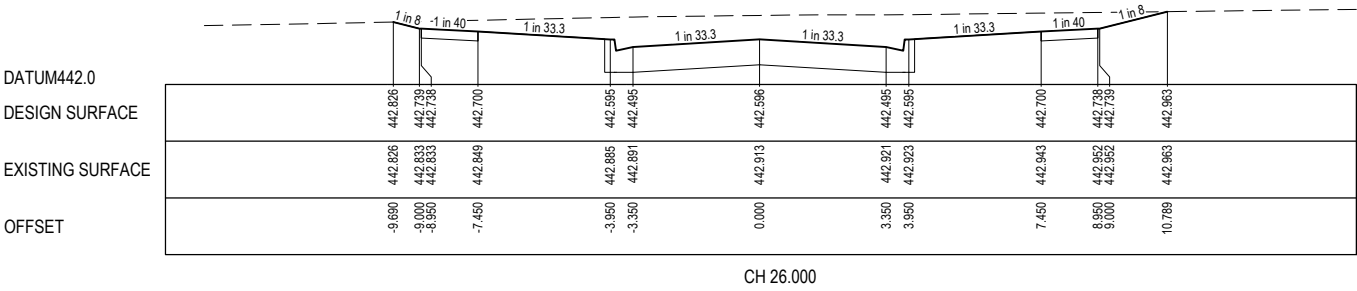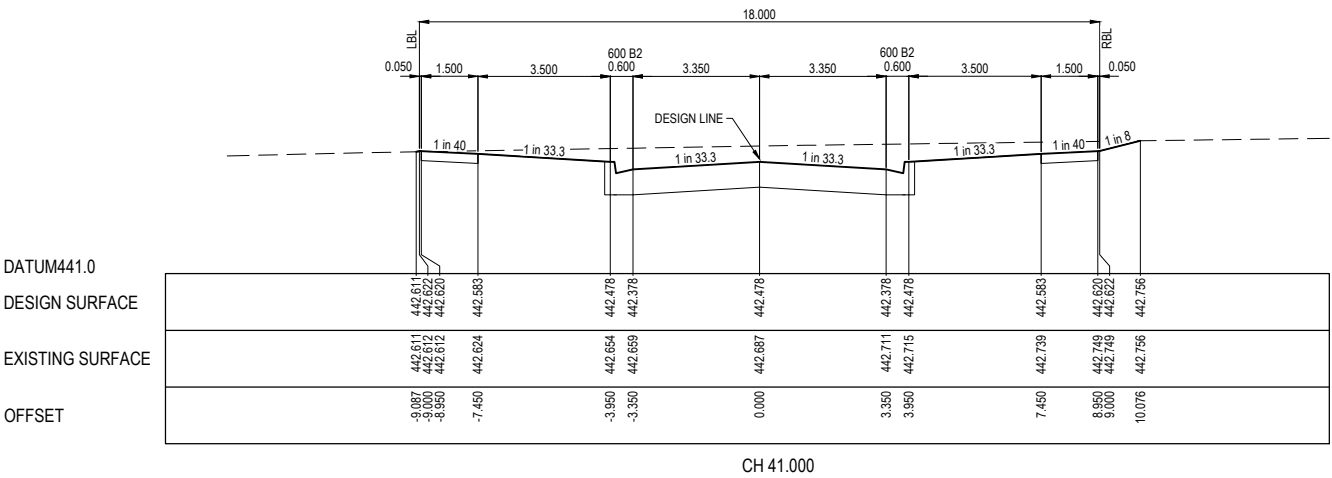


APPROVED  
By JeffColb at 5:11 pm, May 13, 2020

AS CONSTRUCTED  
PLANS

© COPYRIGHT All rights reserved  
Beveridge Williams & Co. Pty Ltd has granted a licence to the principle to use this document for its intended purpose.  
No unauthorised copying is permitted

REV	DESCRIPTION	DATE	DRN.	APP.	REV	DESCRIPTION	DATE	DRN.	APP.
D	CAPPING LAYER DESCRIPTION CHANGE	24.10.19	TT	JS					
C	INTEGRA REVIEW	03.10.19	JS	JZ					
B	AMENDED DRAINAGE	28.08.19	TT	JS					
A	AMENDED AS PER COUNCIL COMMENTS	08.07.19	JS	JZ	F	AS CONSTRUCTED PLANS	13.05.20	TT	JS
P1	AMENDED AS PER INTEGRA COMMENTS	29.05.19	JS	JZ	E	SODERDROM PLACE TO SODER STROM STREET	06.02.20	TT	JS

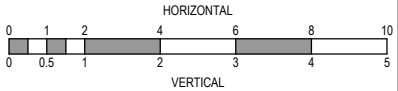

Designed  
Date  
J.SPARK  
29.01.19  
Drawn  
J.SPARK  
Approved  
Date  
J.ZAAL  
29.01.19  
PS Number  
PS825912E



Beveridge Williams

96 Main Road  
Ballarat VIC 3350  
ph: 03 5327 2000  
www.beveridgewilliams.com.au

Project  
Details  
LUCAS  
STAGE G3  
CITY OF BALLARAT

Drawing  
Title  
SODERSTROM STREET CROSS SECTIONS  
(SHEET 7 OF 7)


Sheet 19 of 26

Scale  
1:100 H 1:50 V @ A1

Project Ref	Stage No	Drawing No	Rev
1800971	G3	206	F



X:\18\1800971 Lucas\_Eng\Stage G3\Drawings\1800971-G3-206-RXS.dwg






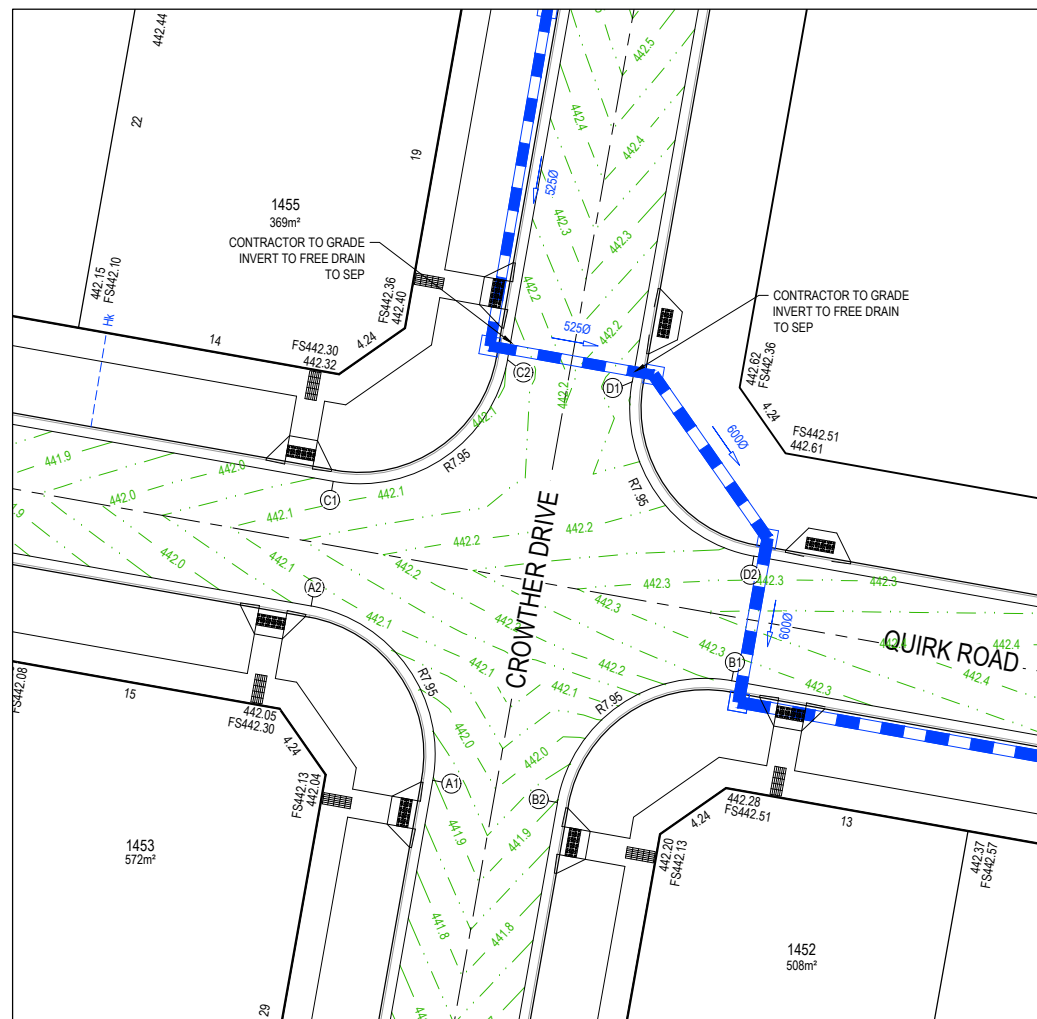


## LEGEND

- STORMWATER DRAIN, PIT & PROPERTY INLET
- MELBOURNE WATER DRAIN & PIT
- SWALE DRAIN
- SEWER & MAINTENANCE STRUCTURES
- HOUSE DRAIN
- TACTILE PAVERS (INDICATIVE ONLY)
- EXISTING HOUSE DRAIN
- RETAINING WALL
- PAVEMENT TREATMENT
- CONCRETE EDGE STRIP WITH SUBSOIL DRAIN
- "NO ROAD" SIGN & BARRIER
- LIMIT OF WORKS
- EXISTING TREE TO BE REMOVED
- PERMANENT SURVEY MARK
- TEMPORARY BENCH MARK
- PROPOSED DRIVEWAY

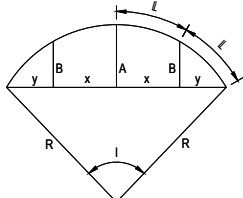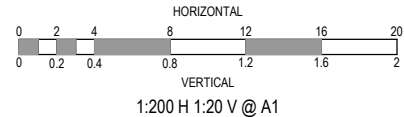

LIP PROFILE SETOUT

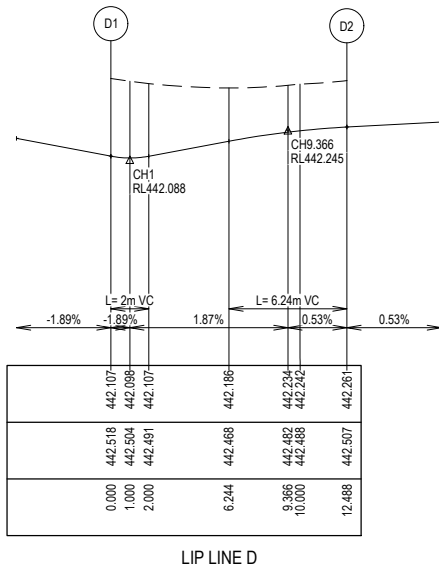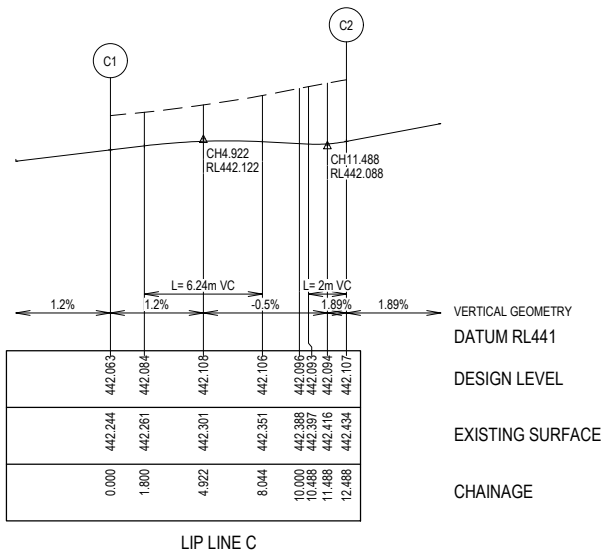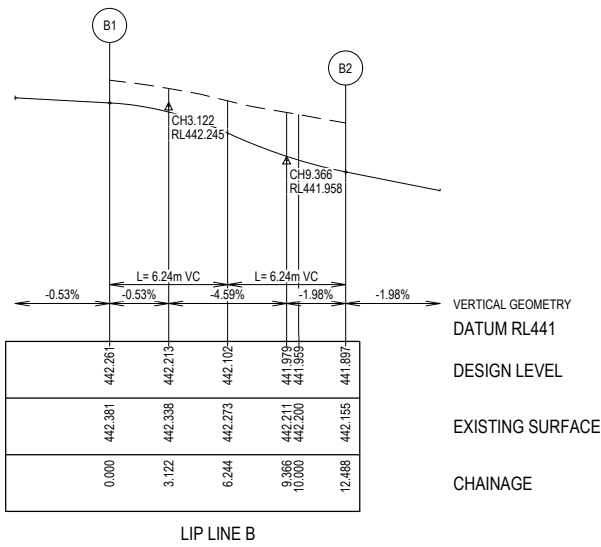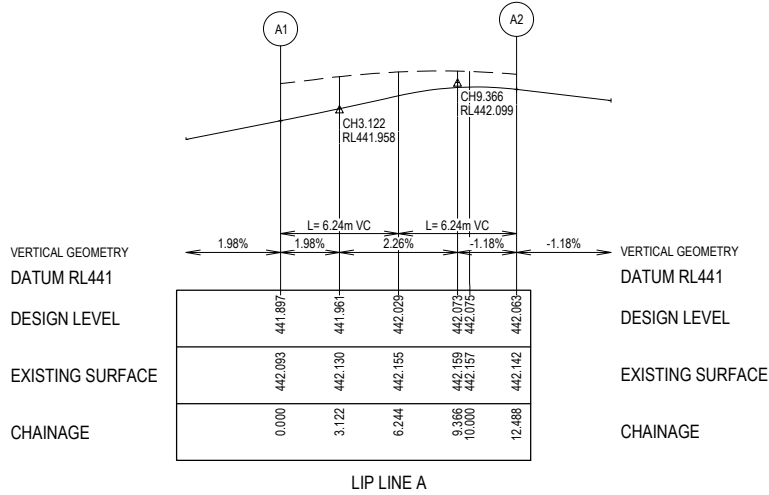

## Alignment A

Point no	Easting	Northing	RL
A1	744648.872	5840910.261	441.897
A2	744642.435	5840919.479	442.063

Curve no	I	Radius	Arc	A	B	X	Y	I	Mid point RL
A1 - A2	90.000	7.950	12.488	2.329	1.723	3.042	2.579	3.122	442.029

## Alignment B

Point no	Easting	Northing	RL
B1	744664.687	5840915.526	442.261
B2	744655.469	5840909.089	441.897

Curve no	I	Radius	Arc	A	B	X	Y	I	Mid point RL
B1 - B2	90.000	7.950	12.488	2.329	1.723	3.042	2.579	3.122	442.102

## Alignment C

Point no	Easting	Northing	RL
C1	744643.607	5840926.076	442.063
C2	744652.825	5840932.512	442.107

Curve no	I	Radius	Arc	A	B	X	Y	I	Mid point RL
C1 - C2	90.000	7.950	12.488	2.329	1.723	3.042	2.579	3.122	442.110

## Alignment D

Point no	Easting	Northing	RL
D1	744659.422	5840931.340	442.107
D2	744665.859	5840922.122	442.261

Curve no	I	Radius	Arc	A	B	X	Y	I	Mid point RL
D1 - D2	90.000	7.950	12.488	2.329	1.723	3.042	2.579	3.122	442.186

## Alignment E

Point no	Easting	Northing	RL
E1	744662.516	5840987.058	442.791
E2	744656.079	5840996.276	442.611

Curve no	I	Radius	Arc	A	B	X	Y	I	Mid point RL
E1 - E2	90.000	7.950	12.488	2.329	1.723	3.042	2.579	3.122	442.722

## Alignment F

Point no	Easting	Northing	RL
F1	744657.251	5841002.873	442.611
F2	744666.469	5841009.310	442.922


Curve no	I	Radius	Arc	A	B	X	Y	I	Mid point RL
F1 - F2	90.000	7.950	12.488	2.329	1.723	3.042	2.579	3.122	442.770

VERTICAL GEOMETRY DATUM RL442

DESIGN LEVEL

EXISTING SURFACE

CHAINAGE

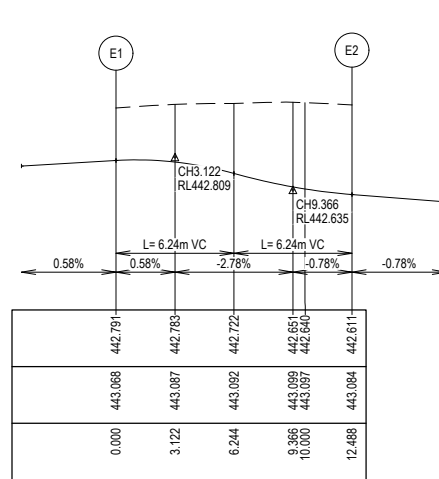


LIP LINE E

VERTICAL GEOMETRY DATUM RL442

DESIGN LEVEL

EXISTING SURFACE

CHAINAGE

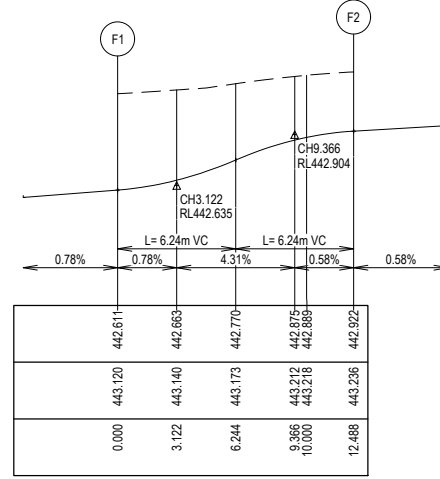

LIP LINE F

**APPROVED**  
By Jeff Colb at 5:11 pm, May 13, 2020

AS CONSTRUCTED  
PLANS

© COPYRIGHT All rights reserved  
Beveridge Williams & Co. Pty Ltd has granted a licence to the principle to use this document for its intended purpose.  
No unauthorised copying is permitted

REV	DESCRIPTION	DATE	DRN.	APP.	REV	DESCRIPTION	DATE	DRN.	APP.
D	CAPPING LAYER DESCRIPTION CHANGE	24.10.19	TT	JS					
C	INTEGRA REVIEW	03.10.19	JS	JZ					
B	AMENDED DRAINAGE	28.08.19	TT	JS					
A	AMENDED AS PER COUNCIL COMMENTS	08.07.19	JS	JZ	F	AS CONSTRUCTED PLANS	13.05.20	TT	JS
P1	AMENDED AS PER INTEGRA COMMENTS	29.05.19	JS	JZ	E	SODERSTROM PLACE TO SODER STROM STREET	06.02.20	TT	JS



Designed Date	J.SPARK 29.01.19
Drawn	J.SPARK
Approved Date	J.ZAAL 29.01.19
PS Number	PS825912E








Project Details	LUCAS STAGE G3 CITY OF BALLARAT
Drawing Title	INTERSECTION DETAILS (SHEET 1 OF 2)

Sheet 20 of 26

Scale  
1:200 @ A1

Project Ref	Stage No	Drawing No	Rev
1800971	G3	300	F

X:\181800971 Lucas\_Eng\Stage G3\Drawings\1800971-G3-300-INT.dwg

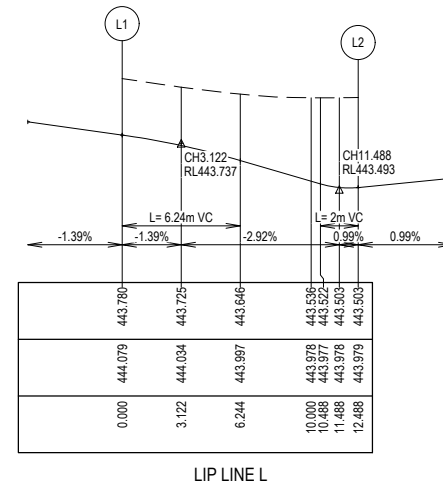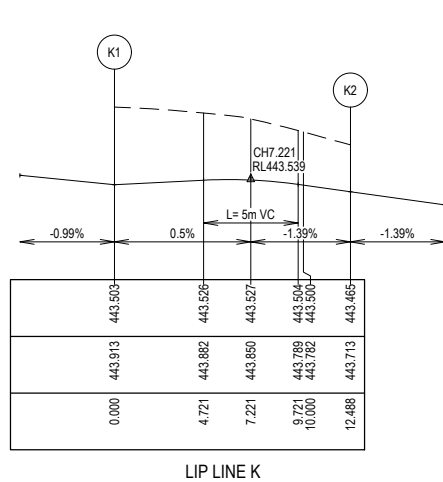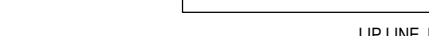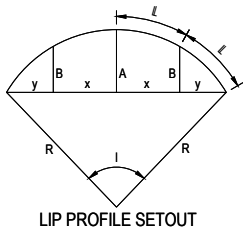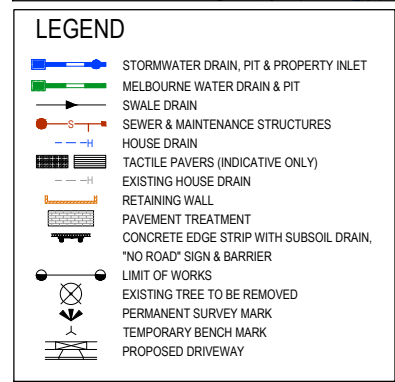


Curve no	I	Radius	Arc	A	B	X	Y	I	Mid point RL
L1 - L2	90.000	7.950	12.488	2.329	1.723	3.042	2.579	3.122	443.646

VERTICAL GEOMETRY  
DATUM RL443  
DESIGN LEVEL  
EXISTING SURFACE  
CHAINAGE



96 Main Road  
Ballarat Vic 3350  
ph: 03 5327 2000  
[www.beveridgewilliams.com.au](http://www.beveridgewilliams.com.au)

Project Ref	Stage No	Drawing No	Rev
1800971	G3	301	F

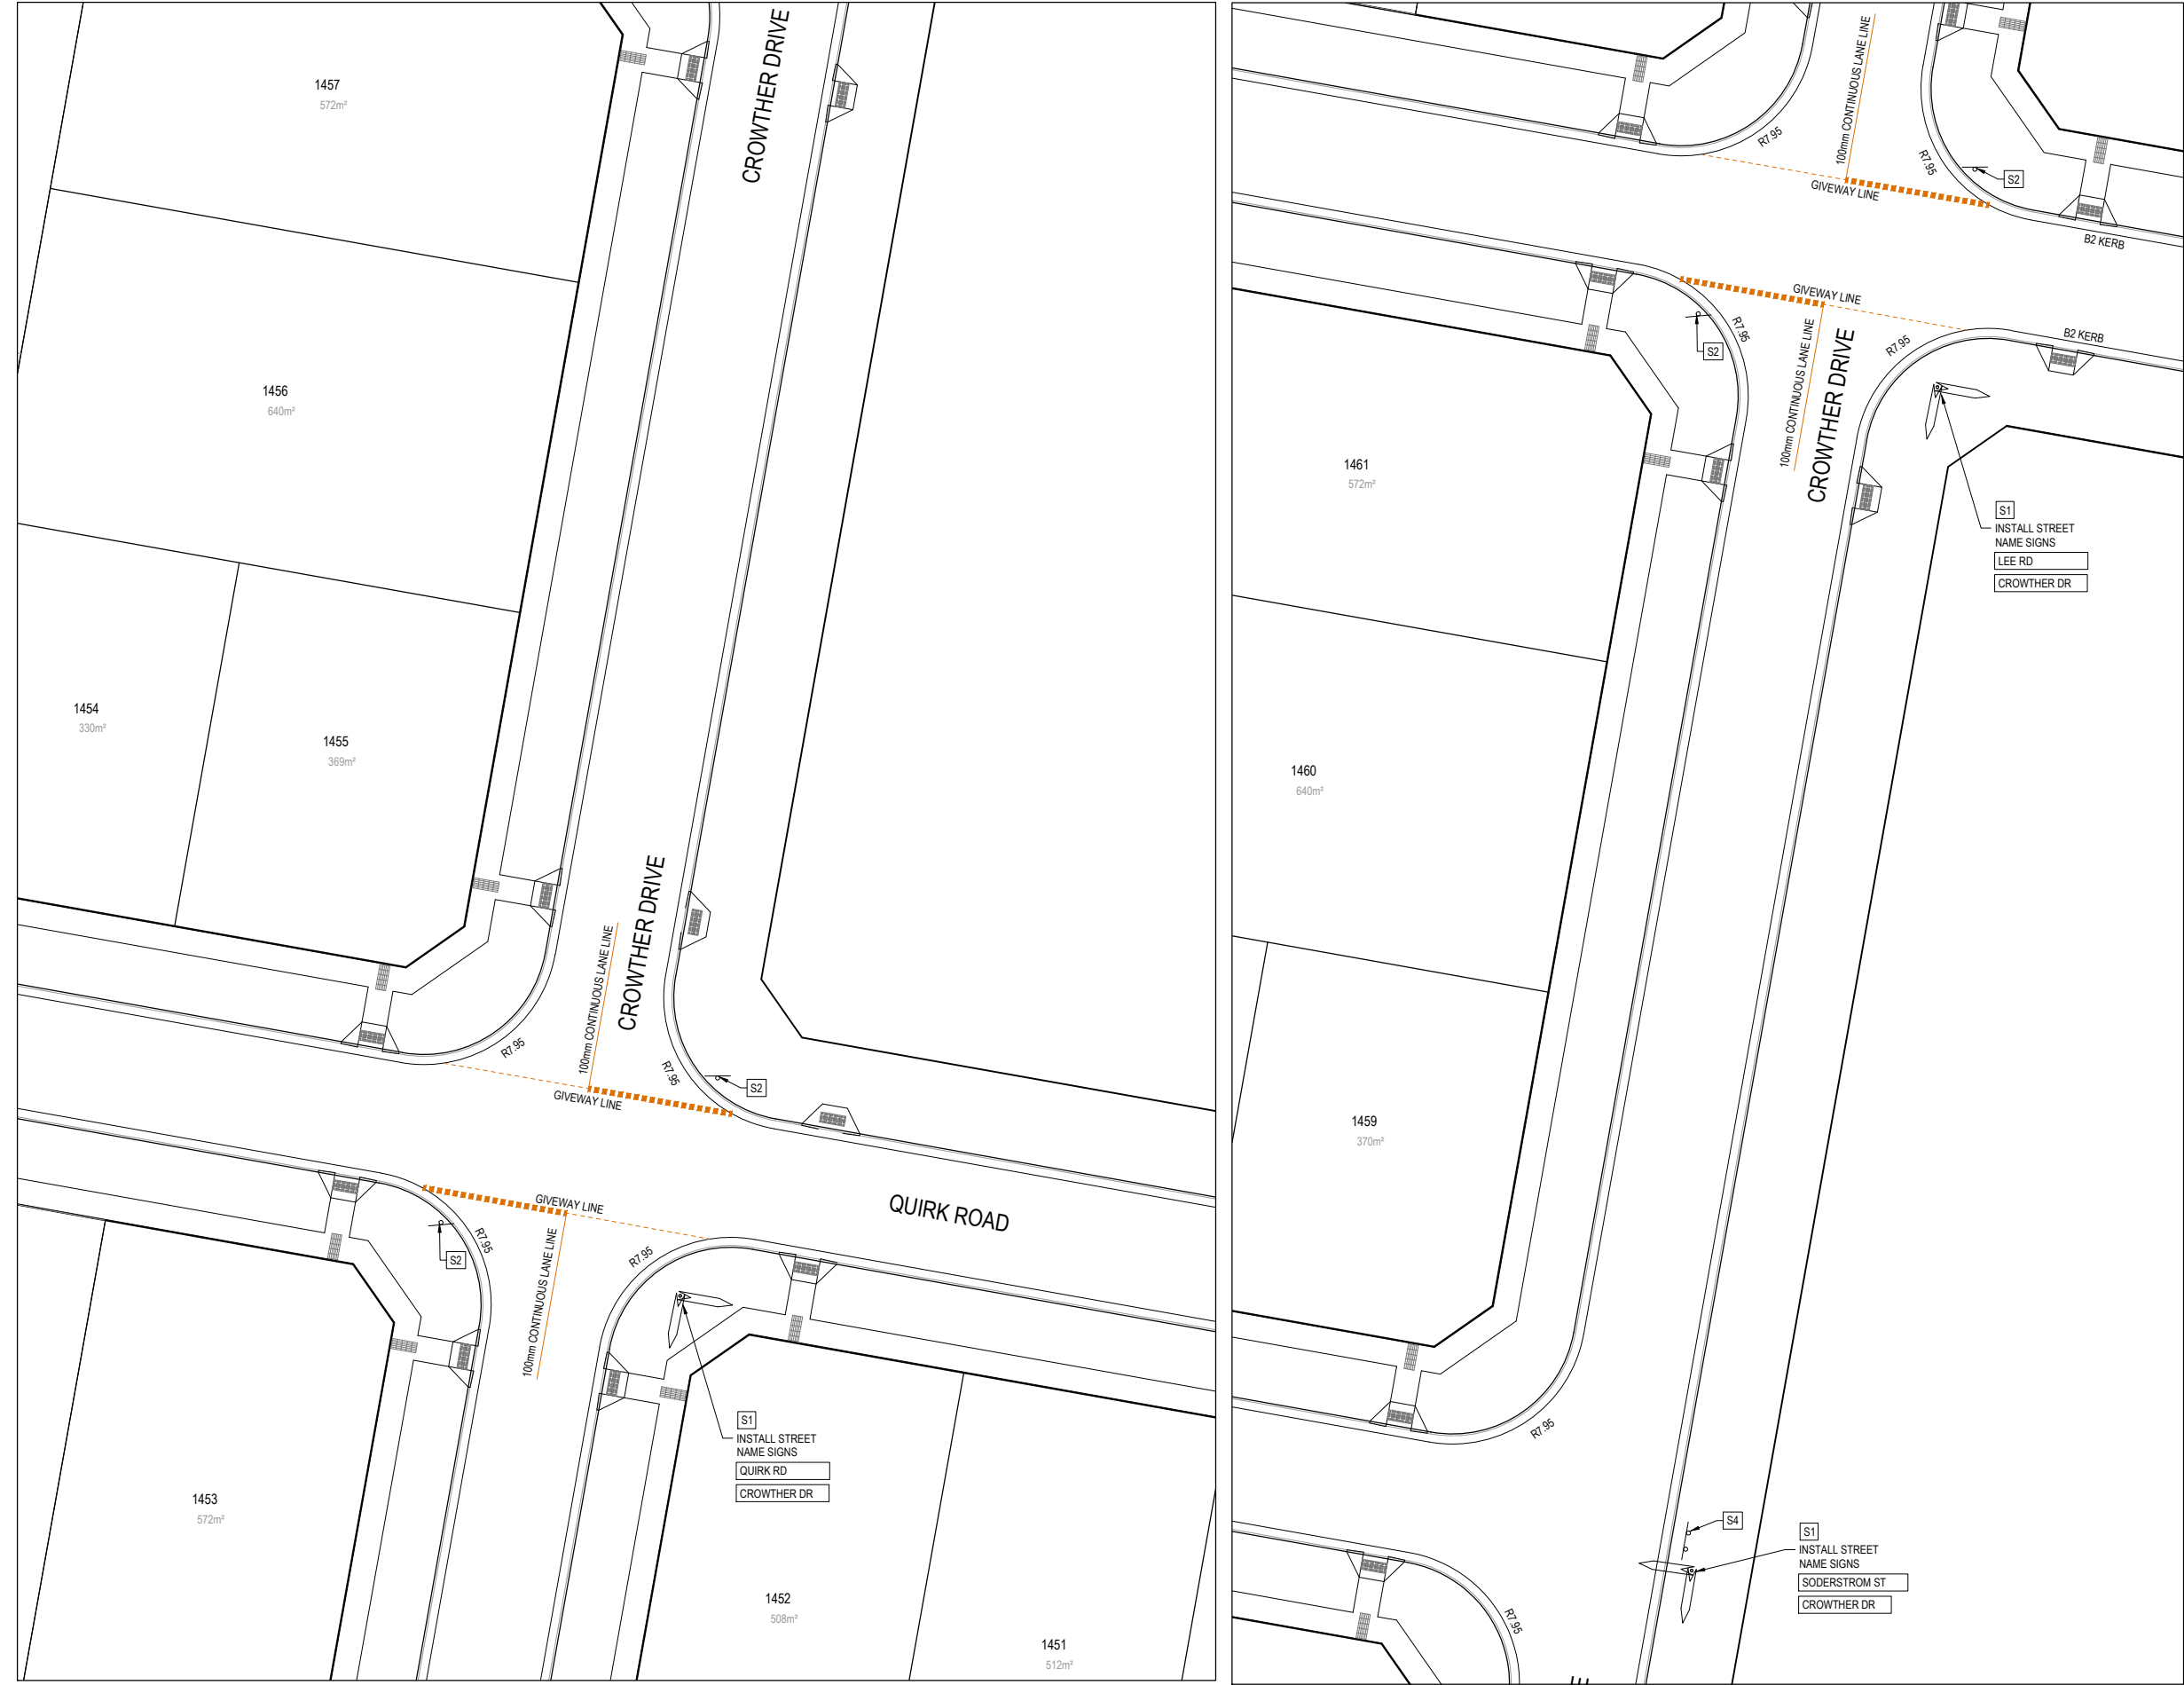

SIGN SCHEDULE

IDENTIFIER	NUMBER	SIGN
S1	STREET NAME SIGN	
S2	R1-2	
S3	D4-5	
S4	D4-2-1	


SIGNS SHALL BE LOCATED SUCH THAT THE EDGE OF THE SIGN IS MINIMUM 0.5m BEHIND THE KERB INVERT.

**APPROVED**  
By JeffColb at 5:11 pm, May 13, 2020

- NOTES
- RRPM'S AT MAX 6m SPACING.
  - LINEMARKING TO BE EXTENDED AT LEAST 5m FROM THE TANGENT POINT
  - LINEMARKING IN ACCORDANCE WITH AS1742.
  - TGSI TO BE INSTALLED IN ACCORDANCE WITH COUNCIL STANDARD SD-C4-1

AS CONSTRUCTED  
PLANS

© COPYRIGHT All rights reserved Beveridge Williams & Co. Pty Ltd has granted a licence to the principle to use this document for its intended purpose. No unauthorised copying is permitted									
D	CAPPING LAYER DESCRIPTION CHANGE	24.10.19	TT	JS					
C	INTEGRA REVIEW	03.10.19	JS	JZ					
B	AMENDED DRAINAGE	28.08.19	TT	JS					
A	AMENDED AS PER COUNCIL COMMENTS	08.07.19	JS	JZ	F	AS CONSTRUCTED PLANS	13.05.20	TT	JS
P1	AMENDED AS PER INTEGRA COMMENTS	29.05.19	JS	JZ	E	SODERSTROM PLACE TO SODERSTROM STREET	06.02.20	TT	JS
REV	DESCRIPTION	DATE	DRN.	APP.	REV	DESCRIPTION	DATE	DRN.	APP.

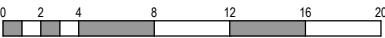

Designed  
Date  
J.SPARK  
29.01.19

Drawn  
J.SPARK

Approved  
Date  
J.ZAAL  
29.01.19

PS Number  
PS825912E



Project  
Details  
LUCAS  
STAGE G3  
CITY OF BALLARAT

Drawing  
Title  
SIGNAGE & LINE MARKING PLANS  
(SHEET 1 OF 2)


Sheet 22 of 26

Scale  
1:200 @ A1

Project Ref	Stage No	Drawing No	Rev
1800971	G3	350	F





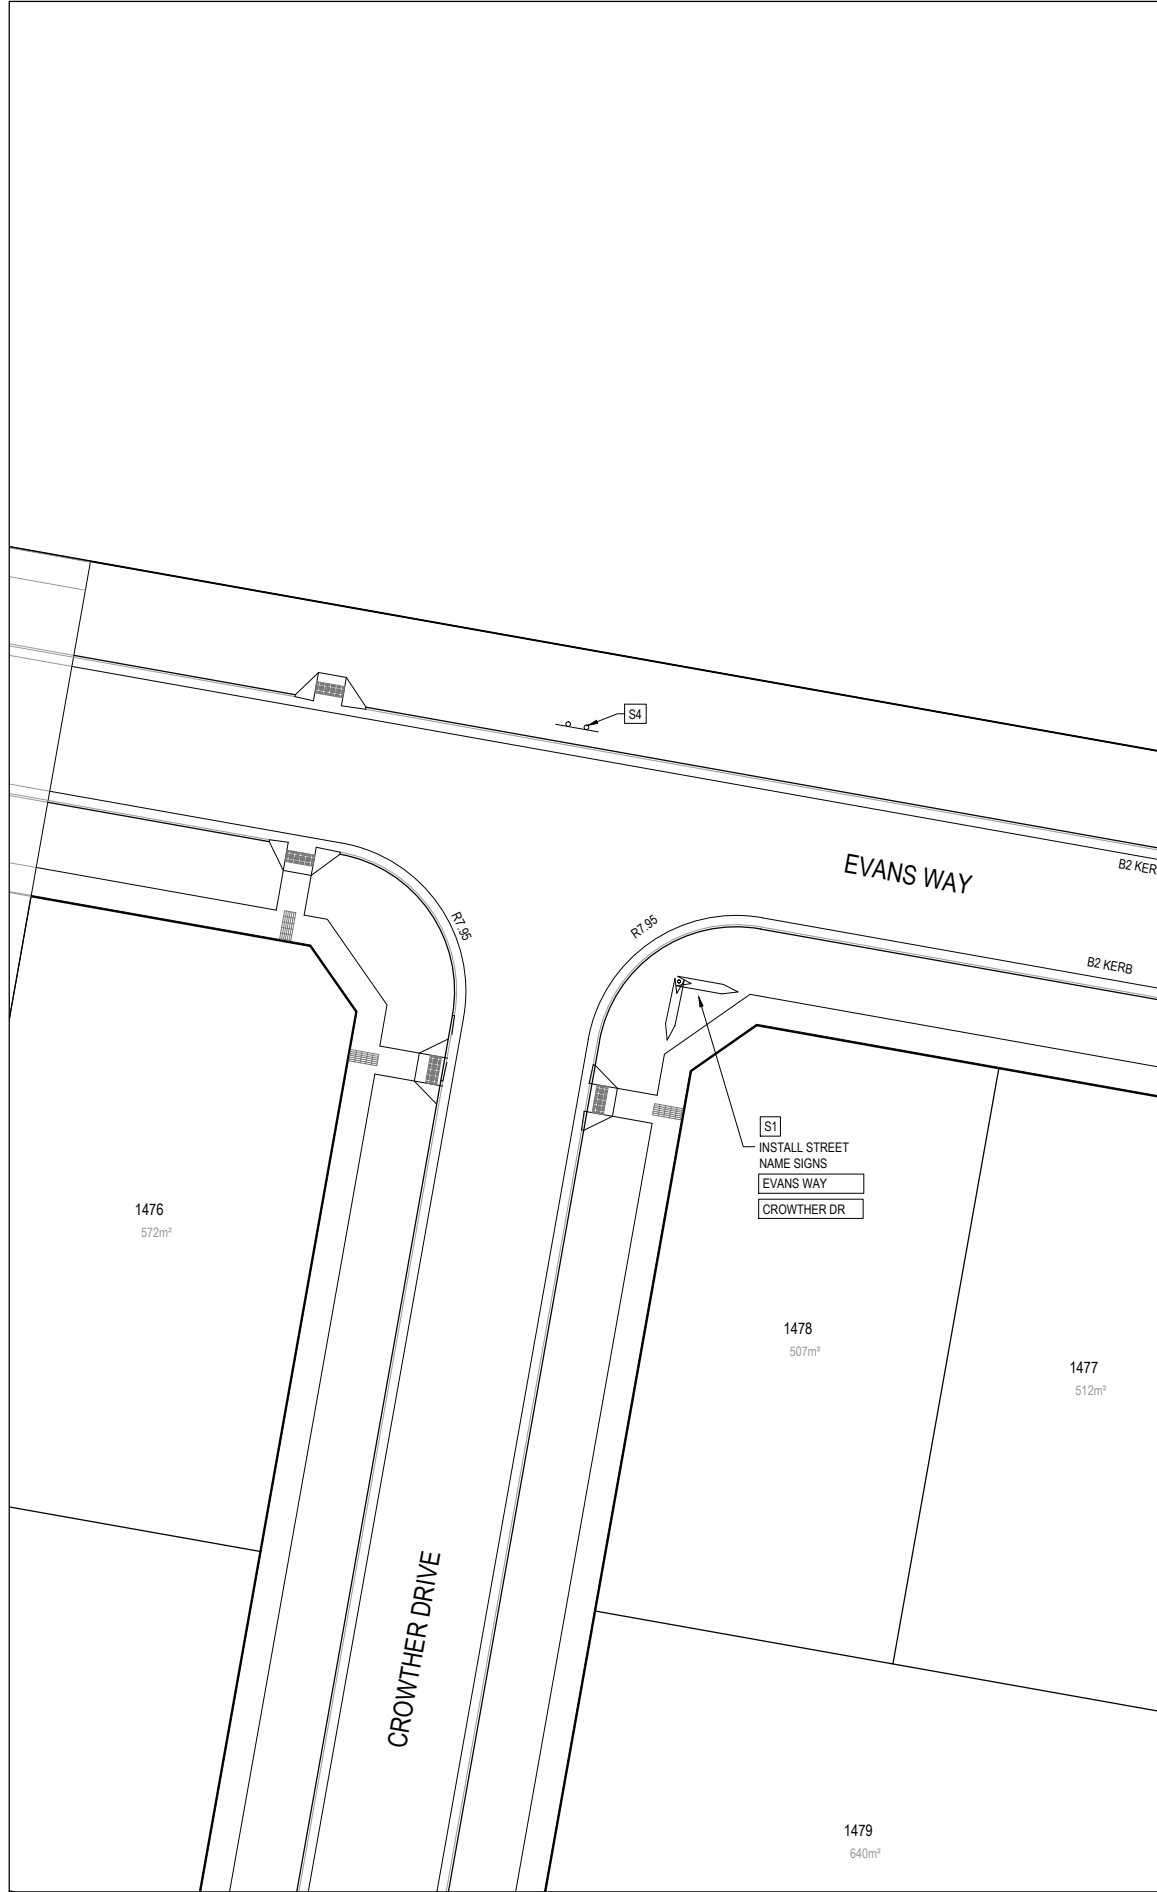

- NOTES
1. RRPM'S AT MAX 6m SPACING.
  2. LINEMARKING TO BE EXTENDED AT LEAST 5m FROM THE TANGENT POINT
  3. LINEMARKING IN ACCORDANCE WITH AS1742.
  4. TGSi TO BE INSTALLED IN ACCORDANCE WITH COUNCIL STANDARD SD-C4-1

SIGN SCHEDULE


IDENTIFIER	NUMBER	SIGN
S1	STREET NAME SIGN	
S2	R1-2	
S3	D4-5	
S4	D4-2-1	

SIGNS SHALL BE LOCATED SUCH THAT THE EDGE OF THE SIGN IS MINIMUM 0.5m BEHIND THE KERB INVERT.

**APPROVED**  
By JeffColb at 5:12 pm, May 13, 2020

AS CONSTRUCTED  
PLANS

© COPYRIGHT All rights reserved Beveridge Williams & Co. Pty Ltd has granted a licence to the principle to use this document for its intended purpose. No unauthorised copying is permitted									
D	CAPPING LAYER DESCRIPTION CHANGE	24.10.19	TT	JS					
C	INTEGRA REVIEW	03.10.19	JS	JZ					
B	AMENDED DRAINAGE	28.08.19	TT	JS					
A	AMENDED AS PER COUNCIL COMMENTS	08.07.19	JS	JZ	F	AS CONSTRUCTED PLANS	13.05.20	TT	JS
P1	AMENDED AS PER INTEGRA COMMENTS	29.05.19	JS	JZ	E	SODERDROM PLACE TO SODER STROM STREET	06.02.20	TT	JS
REV	DESCRIPTION	DATE	DRN.	APP.	REV	DESCRIPTION	DATE	DRN.	APP.

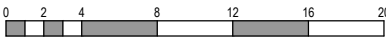

Designed  
Date J.SPARK  
29.01.19

Drawn  
J.SPARK

Approved  
Date J.ZAAL  
29.01.19

PS Number  
PS825912E

BW

Beveridge Williams

96 Main Road  
Ballarat VIC 3350  
ph: 03 5327 2000  
www.beveridgewilliams.com.au

Project  
Details LUCAS  
STAGE G3  
CITY OF BALLARAT

Drawing  
Title SIGNAGE & LINE MARKING PLANS  
(SHEET 2 OF 2)

Sheet 23 of 26

Scale  
1:200 @ A1

Project Ref  
1800971

Stage No  
G3


Drawing No  
351

Rev  
F



NOTES:  
STORMWATER DRAINS SHOWN AS FJ  
CLASS 2 RCP CAN ALSO BE SUBSTITUTED  
FOR SIMILAR PVC PIPE. EG BLACK MAX

LEGEND	
	EXISTING SURFACE
	DESIGN SURFACE
	DRAINAGE PIPE/PIT
	EXISTING DRAINAGE PIPE/PIT
	HYDRAULIC GRADE LINE
	DENOTES 20mm CLASS 3 FCR BACKFILL.
	DENOTES RED DREDGE OR OTHER APPROVED QUARRIED PRODUCT.

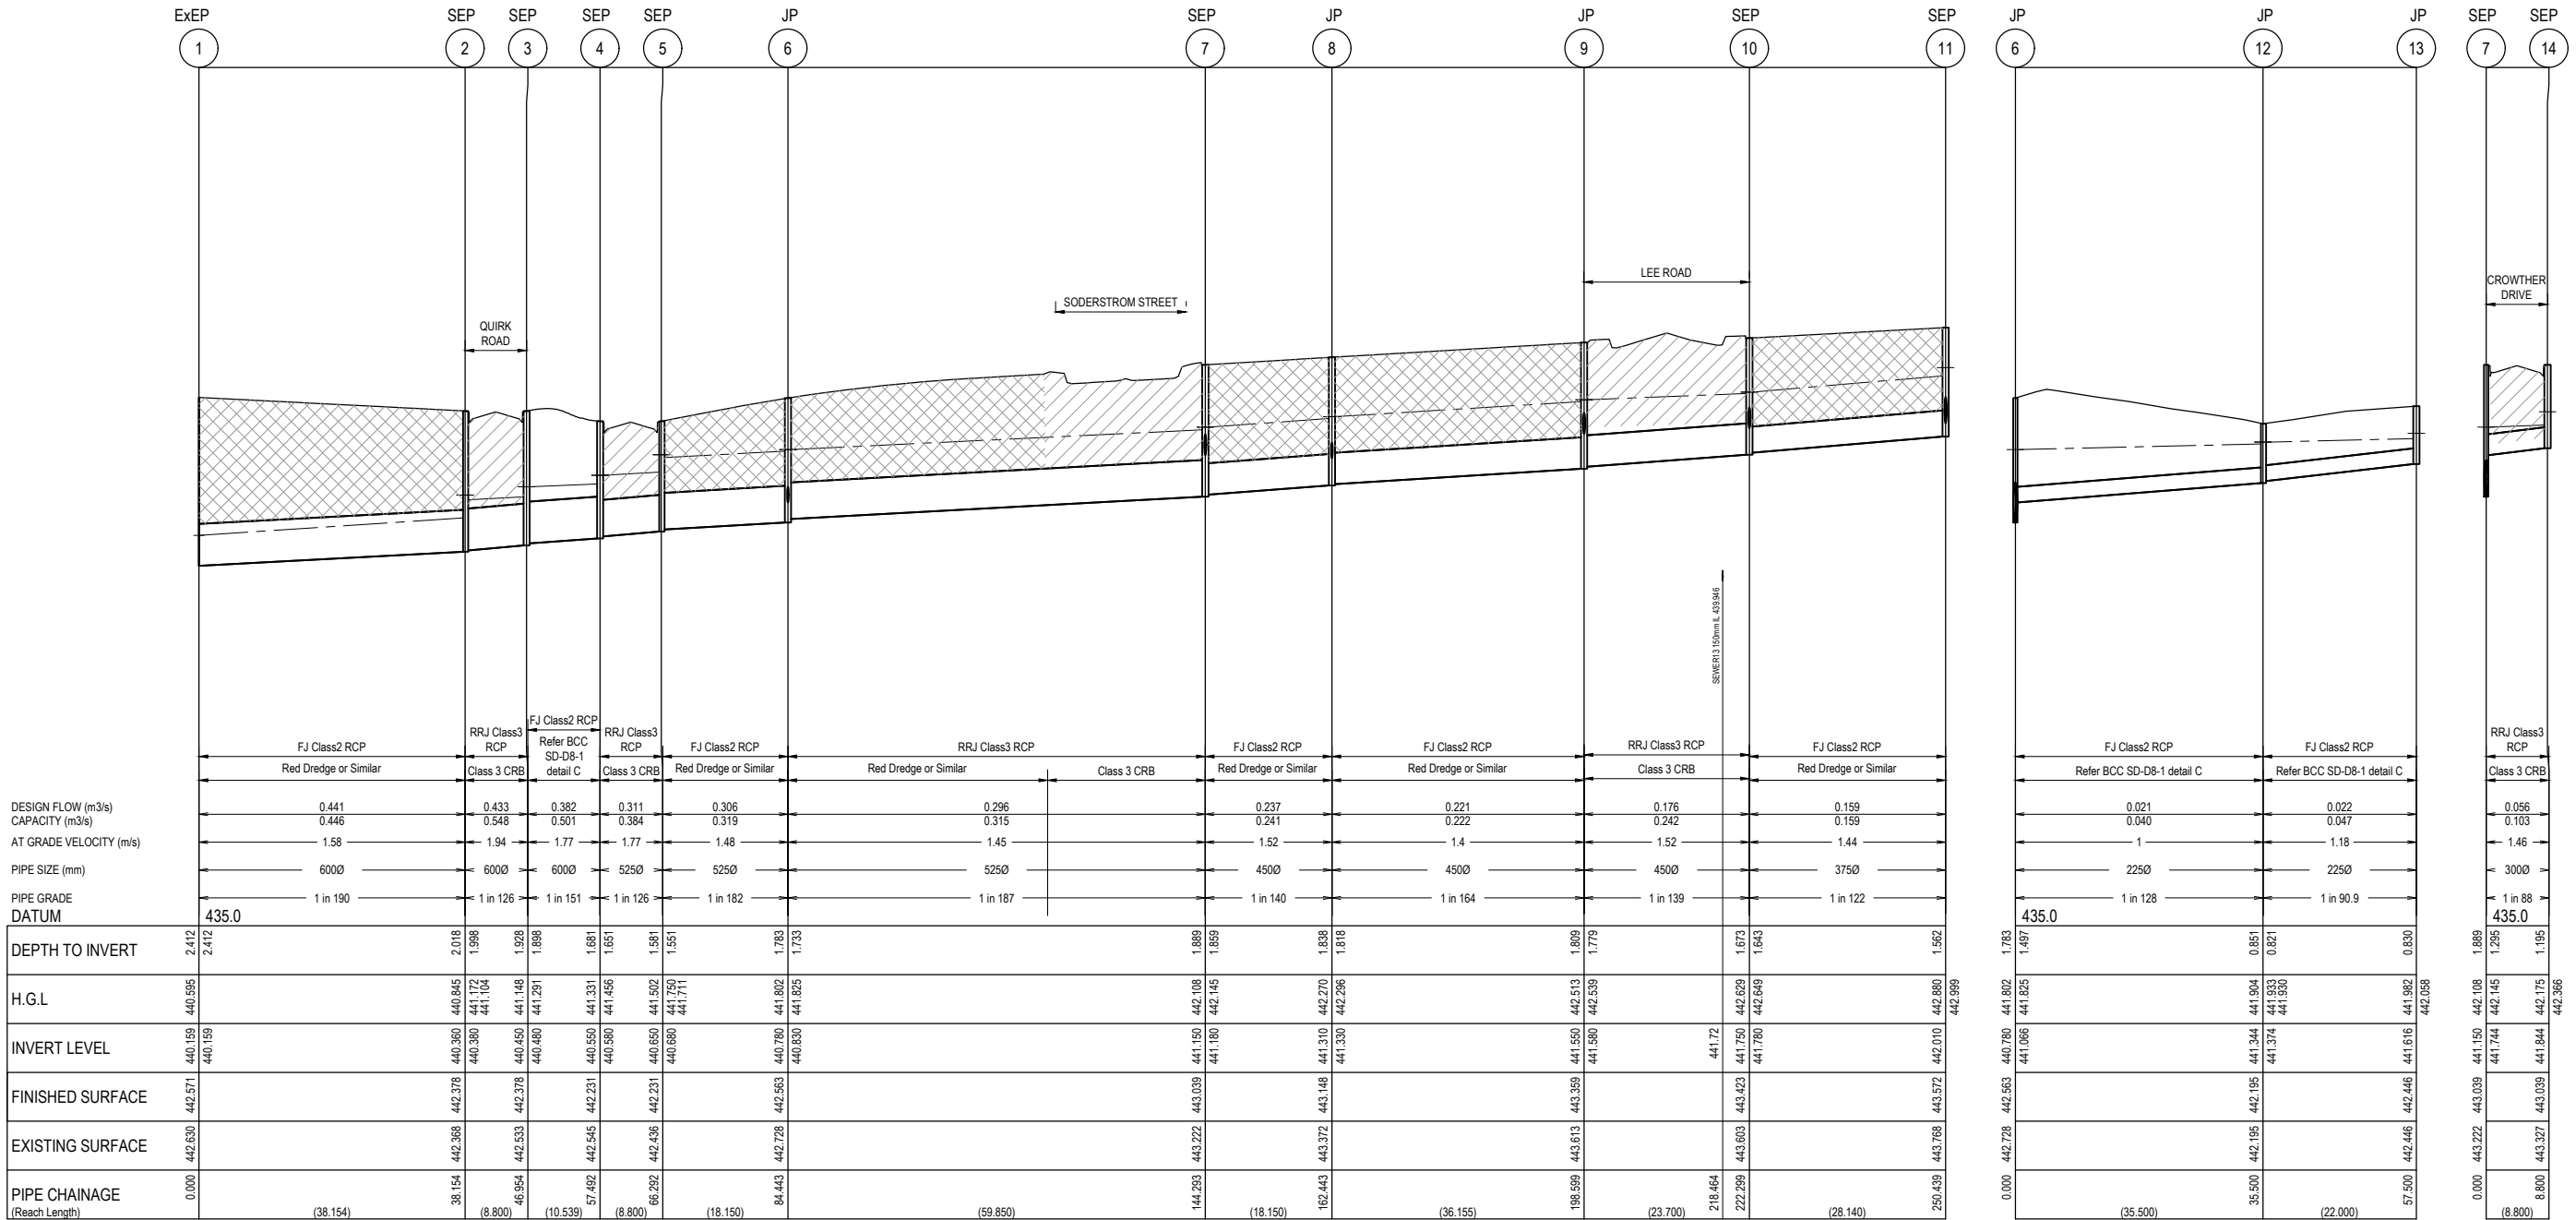


**APPROVED**  
By Jeff Colb at 5:12 pm, May 13, 2020

AS CONSTRUCTED  
PLANS

© COPYRIGHT All rights reserved  
Beveridge Williams & Co. Pty Ltd has granted a licence to the principle to use this document for its intended purpose.  
No unauthorised copying is permitted

REV	DESCRIPTION	DATE	DRN.	APP.	REV	DESCRIPTION	DATE	DRN.	APP.
D	CAPPING LAYER DESCRIPTION CHANGE	24.10.19	TT	JS					
C	INTEGRA REVIEW	03.10.19	JS	JZ					
B	AMENDED DRAINAGE	28.08.19	TT	JS					
A	AMENDED AS PER COUNCIL COMMENTS	08.07.19	JS	JZ	F	AS CONSTRUCTED PLANS	13.05.20	TT	JS
P1	AMENDED AS PER INTEGRA COMMENTS	29.05.19	JS	JZ	E	SODERSTROM PLACE TO SODERSTROM STREET	06.02.20	TT	JS

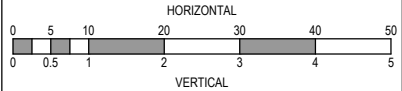

Designed  
Date  
J.SPARK  
29.01.19

Drawn  
J.SPARK

Approved  
Date  
J.ZAAL  
29.01.19

PS Number  
PS825912E

**BW** Beveridge Williams

96 Main Road  
Ballarat Vic 3350  
ph: 03 5327 2000  
www.beveridgewilliams.com.au

Project  
Details  
LUCAS  
STAGE G3  
CITY OF BALLARAT

Drawing  
Title  
DRAINAGE LONGITUDINAL SECTIONS  
(SHEET 1 OF 3)

Sheet 24 of 26

Scale  
1:500 H 1:50 V @ A1


 
Project Ref  
1800971


Stage No  
G3

Drawing No  
400

Rev  
F


X:\18\1800971\Lucas\_Eng\Stage G3\Drawings\1800971-G3-400-DLS.dwg

<b>LEGEND</b>	
_____	EXISTING SURFACE
_____	DESIGN SURFACE
_____	DRAINAGE PIPE/PIT
- - - - -	EXISTING DRAINAGE PIPE/PIT
_____	HYDRAULIC GRADE LINE
	DENOTES 20mm CLASS 3 FCR BACKFILL.
	DENOTES RED DREDGE OR OTHER APPROVED QUARRIED PRODUCT.

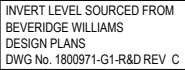

Sheet 25 of 26			
Scale	1:500 H 1:50 V @ A1		
Project Ref	Stage No	Drawing No	Rev
1800971	G3	401	F



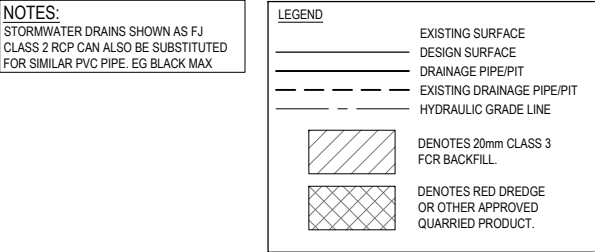

PIT SCHEDULE												
Pit Name	TYPE	EASTING	NORTHING	INTERNAL		INLET		OUTLET		PIT		REMARKS
				WD	LEN	DIA	INV LEV	DIA	INV LEV	SETOUT RL	DEPTH	
1	Ex ENDRPIPE	744702.603	5840907.658	0	0	600	440.159			442.571	2.412	
2	SIDE ENTRY PIT	744665.409	5840914.395	0.9	0.9	600	440.380	600.000	440.360	442.378	2.018	PROVIDE STEP IRONS
3	SIDE ENTRY PIT	744666.584	5840923.060	0.9	0.9	600	440.480	600	440.450	442.378	1.928	PROVIDE STEP IRONS
4	SIDE ENTRY PIT	744660.553	5840931.702	0.9	0.9	525	440.580	600	440.550	442.231	1.681	PROVIDE STEP IRONS
5	SIDE ENTRY PIT	744651.888	5840933.238	0.9	0.9	525	440.680	525	440.650	442.231	1.581	PROVIDE STEP IRONS
6	JUNCTION PIT	744654.964	5840951.125	0.9	0.9	525	440.830	525	440.780	442.563	1.783	PROVIDE STEP IRONS
						225	441.066					
7	SIDE ENTRY PIT	744665.532	5841010.035	0.9	0.9	450	441.180	525	441.150	443.039	1.889	PROVIDE STEP IRONS
						300	441.744					
8	JUNCTION PIT	744668.608	5841027.923	0.9	0.9	450	441.330	450	441.310	443.148	1.838	PROVIDE STEP IRONS
						225	441.700					
9	JUNCTION PIT	744674.932	5841063.521	0.9	0.9	450	441.580	450	441.550	443.359	1.809	PROVIDE STEP IRONS
						300	442.050					
10	SIDE ENTRY PIT	744679.176	5841086.838	0.9	0.9	375	441.780	450	441.750	443.423	1.673	PROVIDE STEP IRONS
						300	442.130					
11	SIDE ENTRY PIT	744684.099	5841114.544	0.9	0.9			375	442.010	443.572	1.562	PROVIDE STEP IRONS
						300	442.277					
						300	442.200					
12	JUNCTION PIT	744620.011	5840957.335	0.6	0.9	225	441.374	225	441.344	442.195	0.851	
13	JUNCTION PIT	744623.860	5840978.996	0.6	0.9			225	441.616	442.446	0.830	
14	SIDE ENTRY PIT	744674.197	5841008.500	0.75	0.9			300	441.844	443.039	1.195	PROVIDE STEP IRONS
15	JUNCTION PIT	744633.655	5841034.132	0.6	0.9	225	442.009	225	441.979	442.876	0.898	
16	JUNCTION PIT	744637.504	5841055.793	0.6	0.9			225	442.181	443.034	0.853	
17	SIDE ENTRY PIT	744692.340	5841067.999	0.9	0.9	300	442.430	300	442.400	443.725	1.325	PROVIDE STEP IRONS
18	SIDE ENTRY PIT	744693.875	5841076.664	0.75	0.9			300	442.530	443.720	1.190	PROVIDE STEP IRONS
19	SIDE ENTRY PIT	744687.841	5841085.303	0.75	0.9			300	442.228	443.423	1.195	PROVIDE STEP IRONS
20	SIDE ENTRY PIT	744692.764	5841113.009	0.75	0.9			300	442.377	443.572	1.195	PROVIDE STEP IRONS
21	SIDE ENTRY PIT	744693.720	5841168.700	0.9	0.9	300	442.624	300	442.594	443.864	1.270	PROVIDE STEP IRONS
22	SIDE ENTRY PIT	744702.385	5841167.165	0.75	0.9			300	442.669	443.864	1.195	PROVIDE STEP IRONS
23	EX.SIDE ENTRY PIT	744742.010	5841347.612	0.9	0.9	450	442.050	450	EX.442.03	443.901	1.871	EX SIDE ENTRY PIT
24	SIDE ENTRY PIT	744733.372	5841341.580	0.9	0.9	450	442.110	450	442.090	443.621	1.531	PROVIDE STEP IRONS
						300	442.344					
25	SIDE ENTRY PIT	744728.448	5841313.864	0.9	0.9	300	442.241	450	442.211	443.838	1.627	PROVIDE STEP IRONS
26	SIDE ENTRY PIT	744719.783	5841315.403	0.9	0.9	225	442.320	400	442.288	443.838	1.550	PROVIDE STEP IRONS
27	JUNCTION PIT	744688.670	5841320.931	0.6	0.9	225	442.600	225	442.570	443.740	1.170	PROVIDE STEP IRONS
28	JUNCTION PIT	744676.776	5841253.979	0.6	0.9			225	443.200	444.173	0.973	
29	SIDE ENTRY PIT	744724.707	5841343.119	0.75	0.9			300	442.426	443.621	1.195	PROVIDE STEP IRONS

## NOTES


1. SETOUT CO-ORDINATES TO PIT CENTRE
2. SETOUT LEVEL TO PIT COVER LEVEL
3. STEP IRONS ARE TO BE PROVIDED IN PIT'S DEEPER THAN 1m
4. COVER LEVELS AND PIT CO-ORDINATES ARE APPROX ONLY AND SHOULD BE CONSTRUCTED TO SUIT FINISHED SURFACE
5. PIT'S IN NON TRAFFICABLE AREAS TO HAVE CONCRETE LIDS AND SURROUNDS AS PER BALLARAT CITY STANDARD DRAWING SD-P1-1 / SD-P10-1

**APPROVED**  
By JeffColb at 5:12 pm, May 13, 2020

AS CONSTRUCTED  
PLANS

Scale  
1:500 H 1:50 V @ A1

Project Ref	Stage No	Drawing No	Re
1800971	G3	402	F

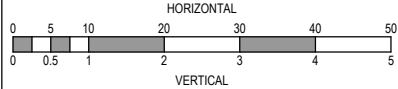

Designed	J.SPARK
Date	29.01.19
Drawn	J.SPARK
Approved	J.ZAAL
Date	29.01.19
PS Number	PS825912E

**BW** Beveridge Williams  
96 Main Road  
Ballarat Vic 3350  
ph: 03 5327 2000  
[www.beveridgewilliams.com.au](http://www.beveridgewilliams.com.au)

Project Details	LUCAS STAGE G3 CITY OF BALLARAT
Drawing Title	DRAINAGE LONGITUDINAL SECTIONS & PIT SCHEDULE (SHEET 3 OF 3)